


WELL LOCATIONS:

WELL #1 = 520' N & 330' W FROM CENTER SECTION 33


WELL #2 = 630' N & 510' W FROM CENTER SECTION 33

WELL #3 = 790' N & 275' W FROM CENTER SECTION 33

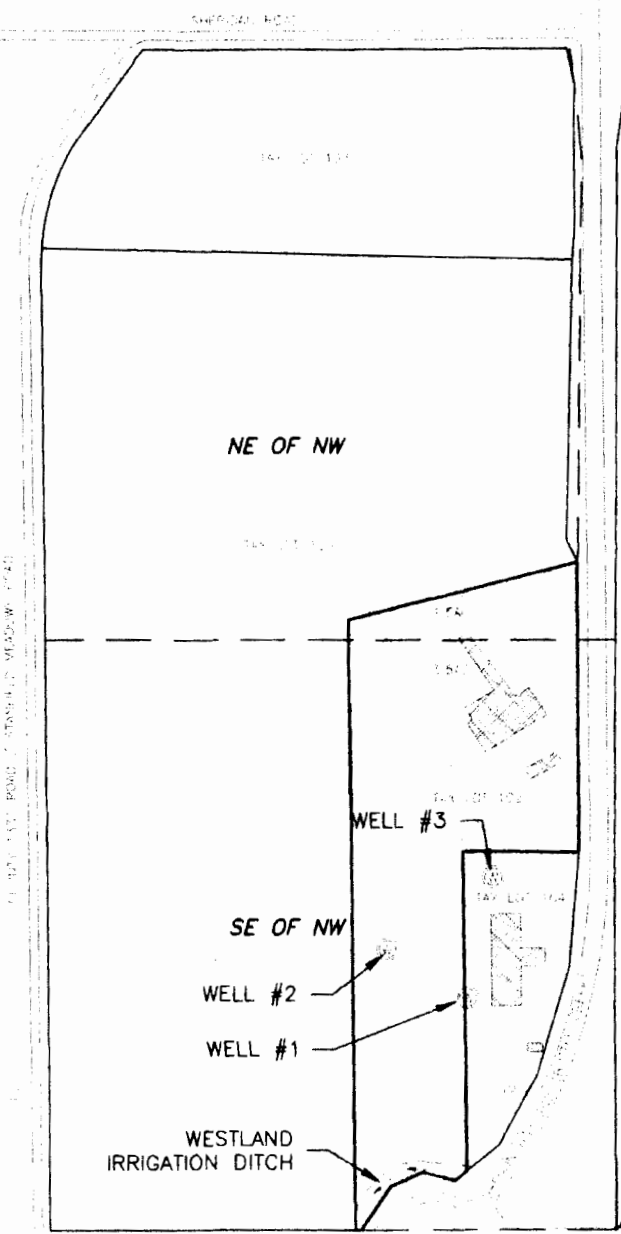


NOTE:

THE PREPARATION OF THIS MAP IS FOR THE PURPOSE OF IDENTIFYING THE LOCATION OF WATER RIGHTS ONLY, AND HAS NO INTENT TO PROVIDE DIMENSIONS OR LOCATIONS OF PROPERTY OWNERSHIP LINES.

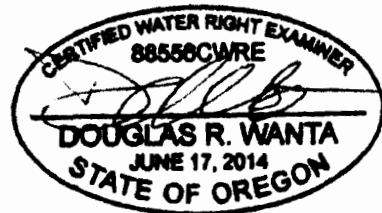

RENEWS: 6/30/2016

CENTER SECTION 33
4N, 28E

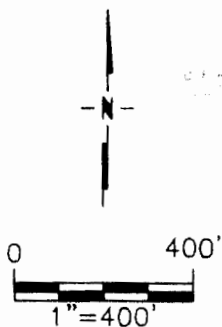

EXPLANATION:

EXISTING STRUCTURE

RECEIVED BY OWRD

MAY 13 2015

SALEM, OR

T 12058