


JUNCTION CITY OREGON

RECEIVED
JUN 1 1930
S. P. R. R.

SCALE - 1" = 600'

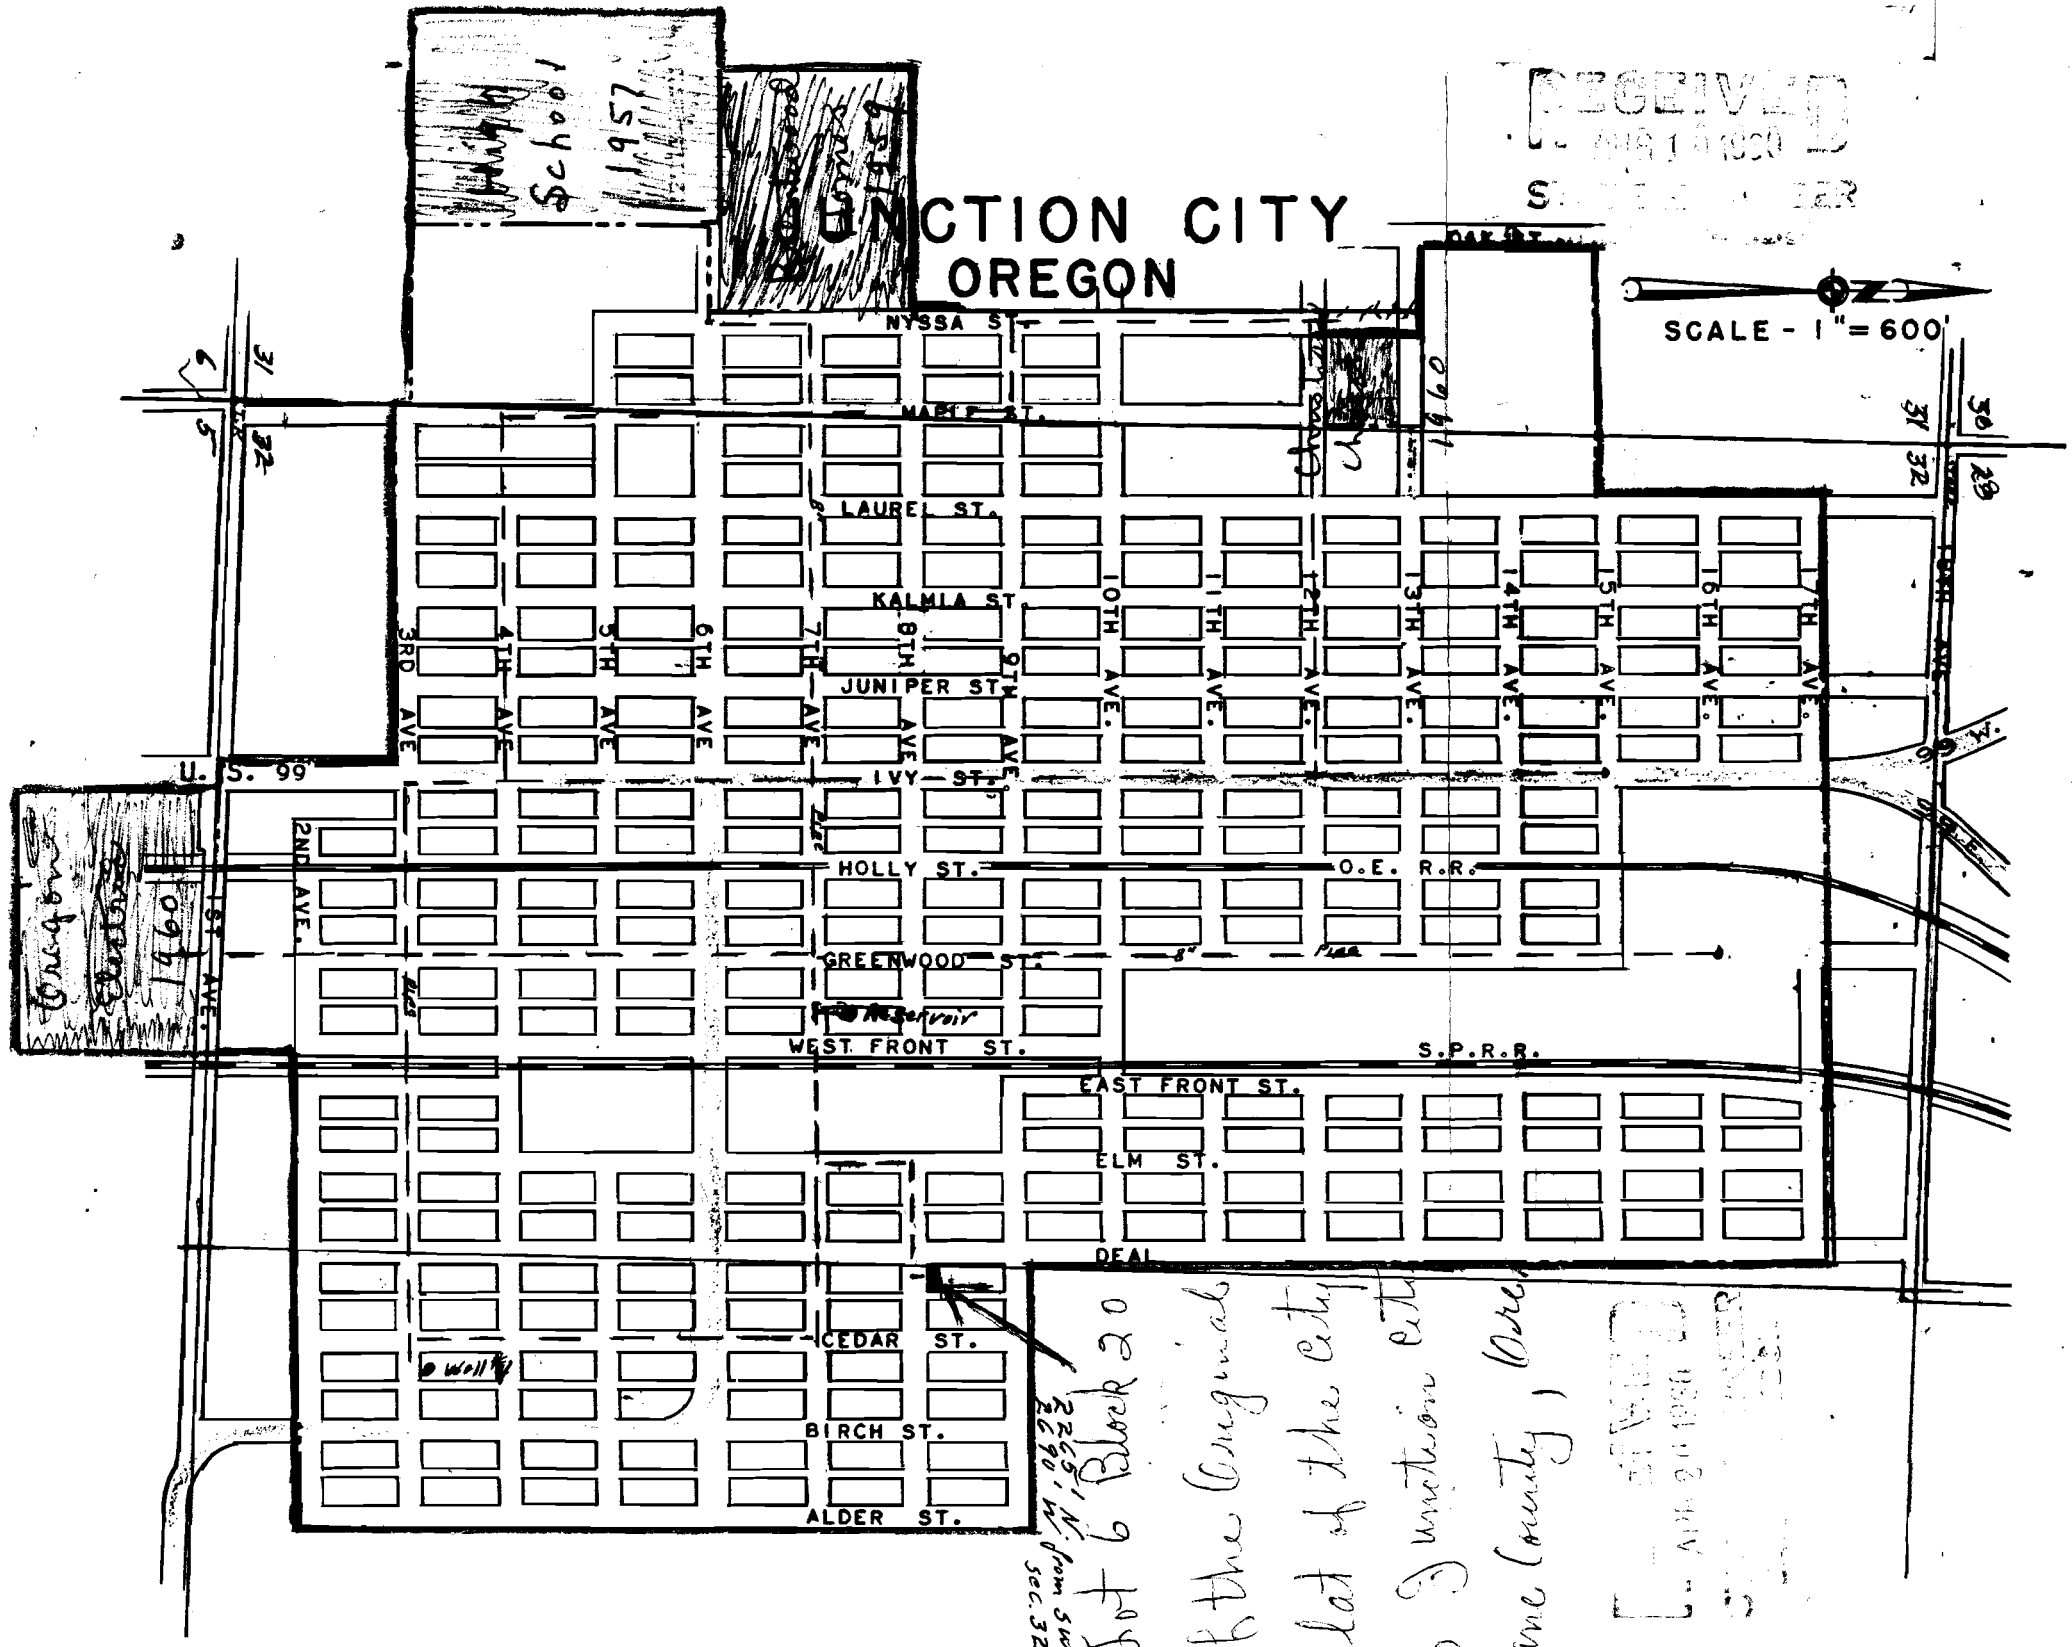


Part 6 Block 20
2268' N. from SW cor
2290' W. from SW cor
Sec. 32

of the Original
Plat of the City
of Junction City,
Lane County, Ore.

RECEIVED
JUN 1 1930
S. P. R. R.