
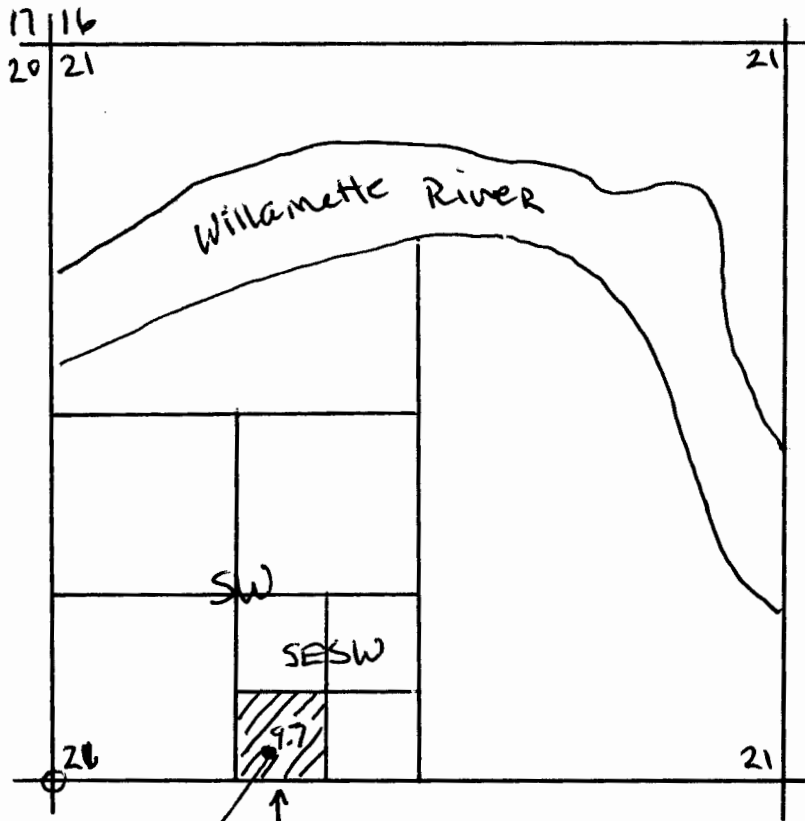


# Application Map

T3S R1E Sec 21

Scale  
1" = 1320'

1" = 1320'

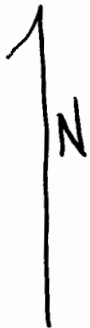

WELL LOCATION:  
165' N + 1485 E from SW Corner Section 21

RECEIVED BY OWRD

NOV 19 2014

SALEM, OR