


# T7S, R1W

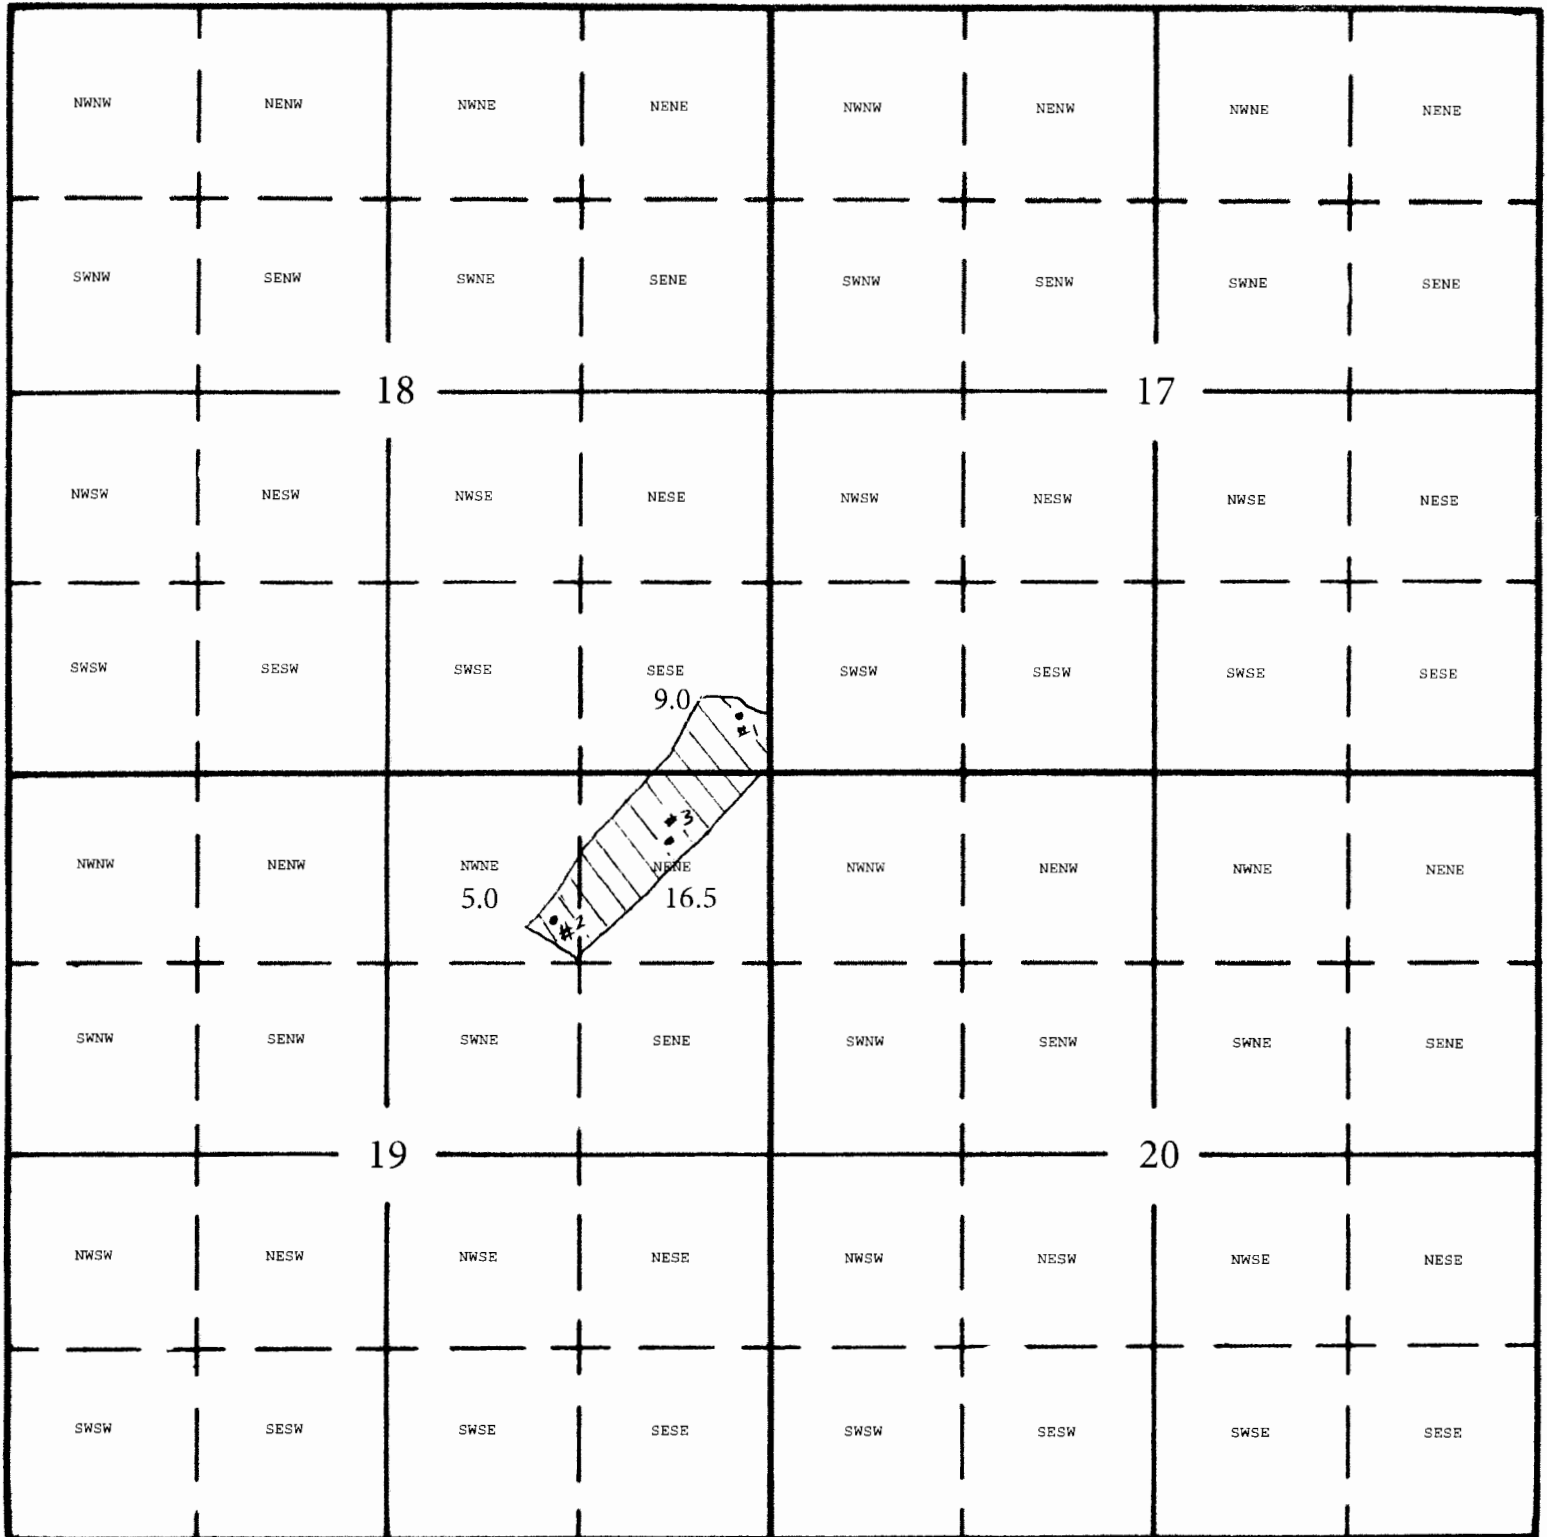

South

## RECEIVED

MAR 24 2015

- WELL 1: 400' N & 200' W FR SE COR, S18
- WELL 2: 975' S & 1475' W FR NE COR, S19
- WELL 3: 450' S & 725' W FR NE COR, S19

WATER RESOURCES DEPT  
SALEM, OREGON