


T15, R4E  
Sec. 17 NE 1/4

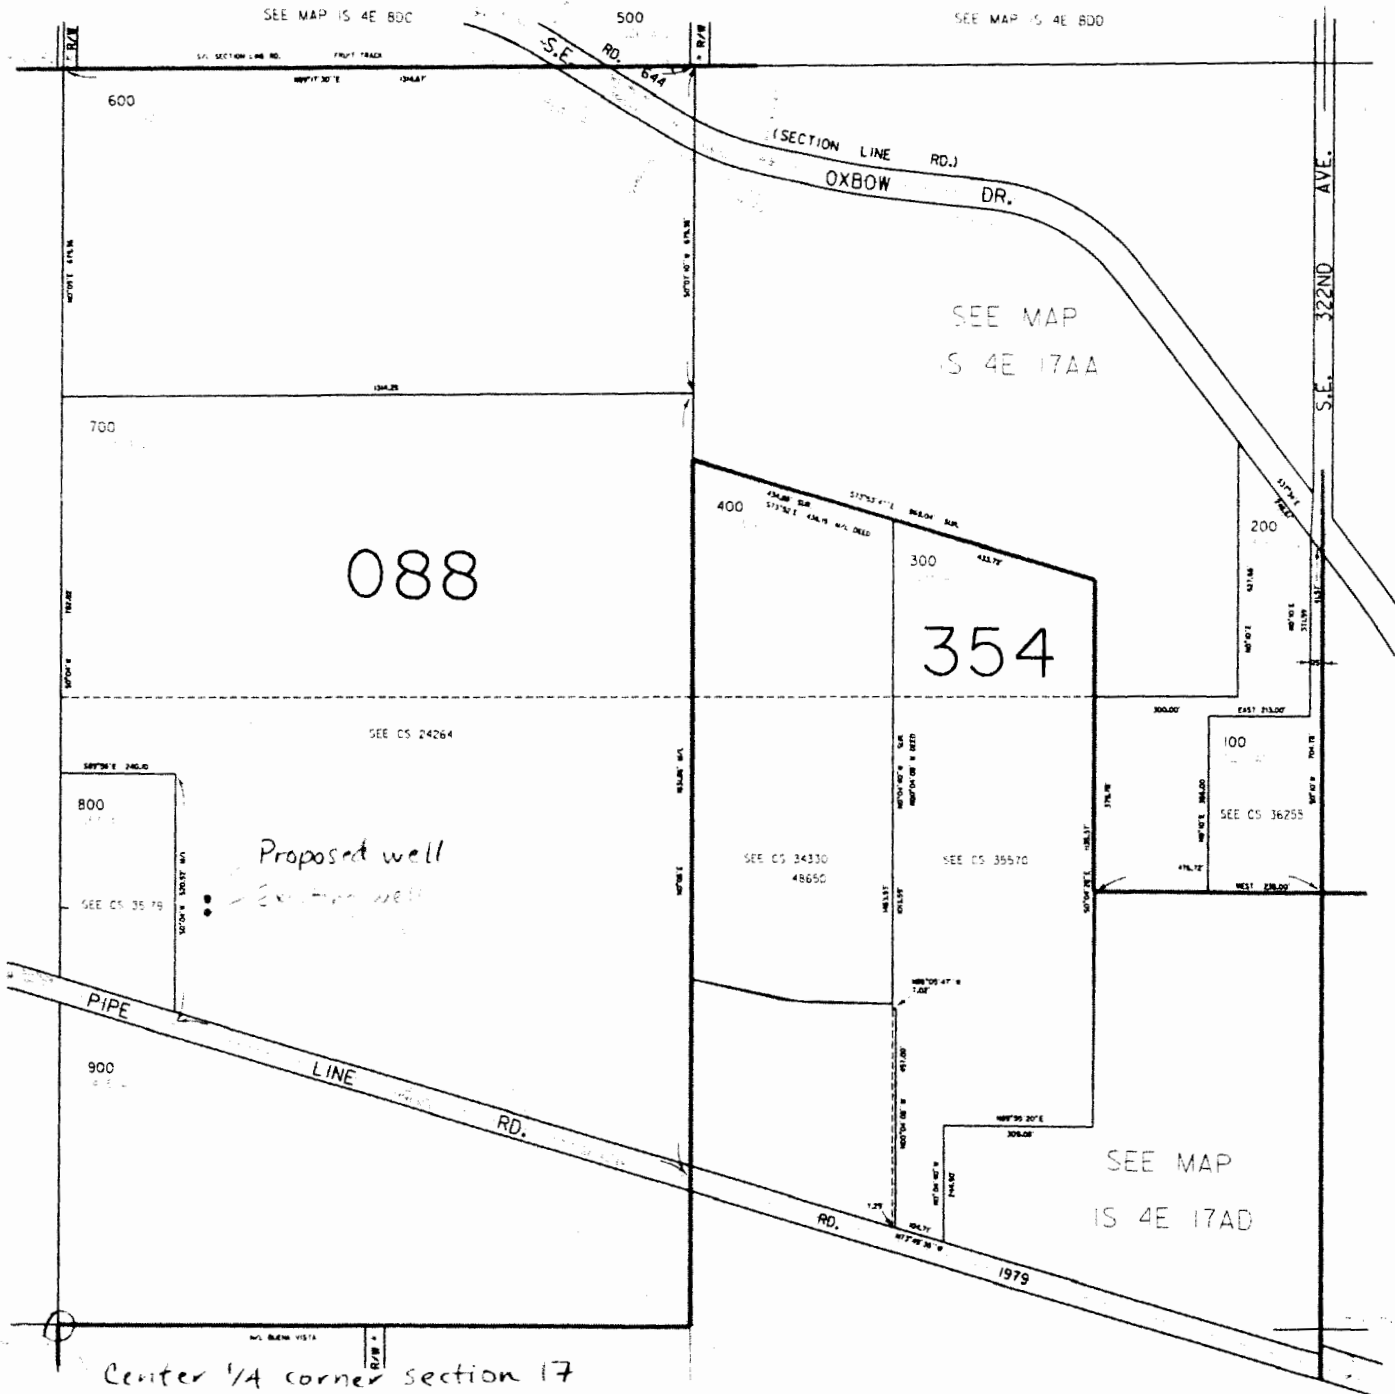

Existing well (to be abandoned) located  
860' N, 300' E from  
center of Section 17

Proposed well located  
880' N, 300' E from  
center of section 17



RECEIVED  
AUG 14 2014  
OWRD

1" = 400'