


T34S R6W

RECEIVED BY OWRD

APR 09 2015

SALEM, OR

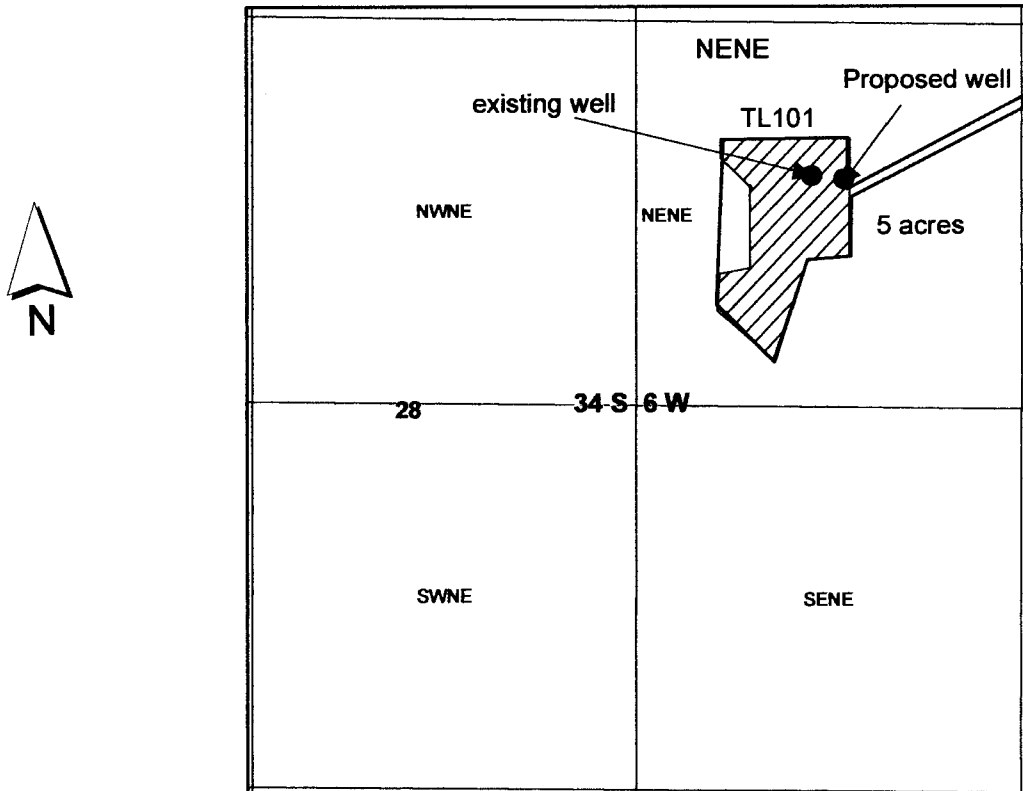

Sec 28 Center

1 inch = 660 feet

Proposed well will be in the area of 528 ft south and 621 ft west from NE corner of Sec 28

Existing well is 517 feet south and 714 feet west from NE corner Sec 28

G-12042