FINAL PROOF SURVEY MAP

RAINBOW HEIGHTS HOMEOWNERS ASSOCIATION
Application G-16018 Permit G-16042

T 8 S R 3 W, W.M. Section 27

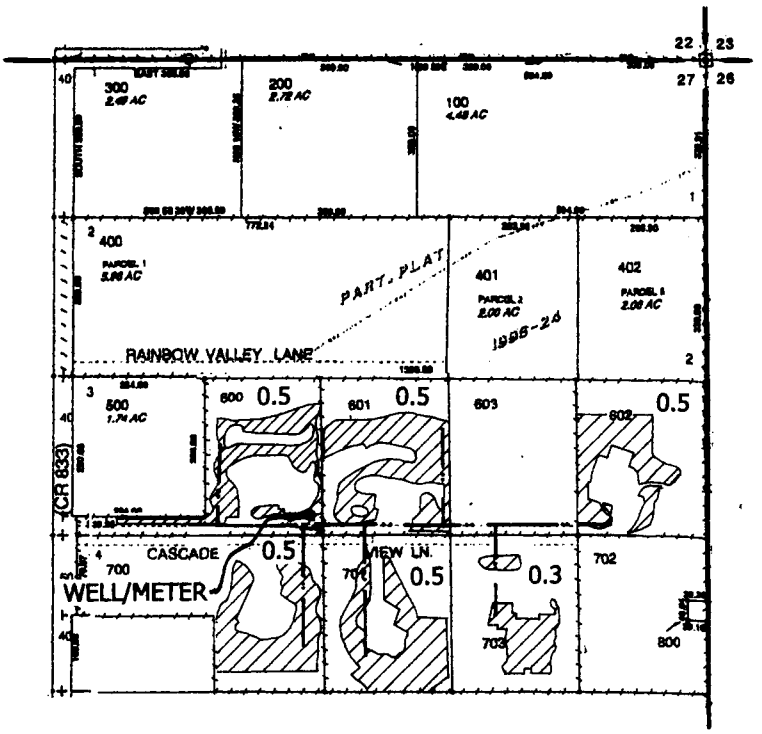

NORTH

Well/Meter ●
Section Line
Tax Lot Line
Pipe line

Well/Meter: 945' S & 820' W
Both from the NE corner Section 27

Scale 1" = 400'

Certified Water Rights Examiner
#75
DONALD E. KNADER
Nov. 19, 1987
STATE OF OREGON

This map is not intended to provide legal dimensions or locations of property ownership

RENEWAL DATE: 6/30/2011