

# SECTION PLAT

Section 4,5,32

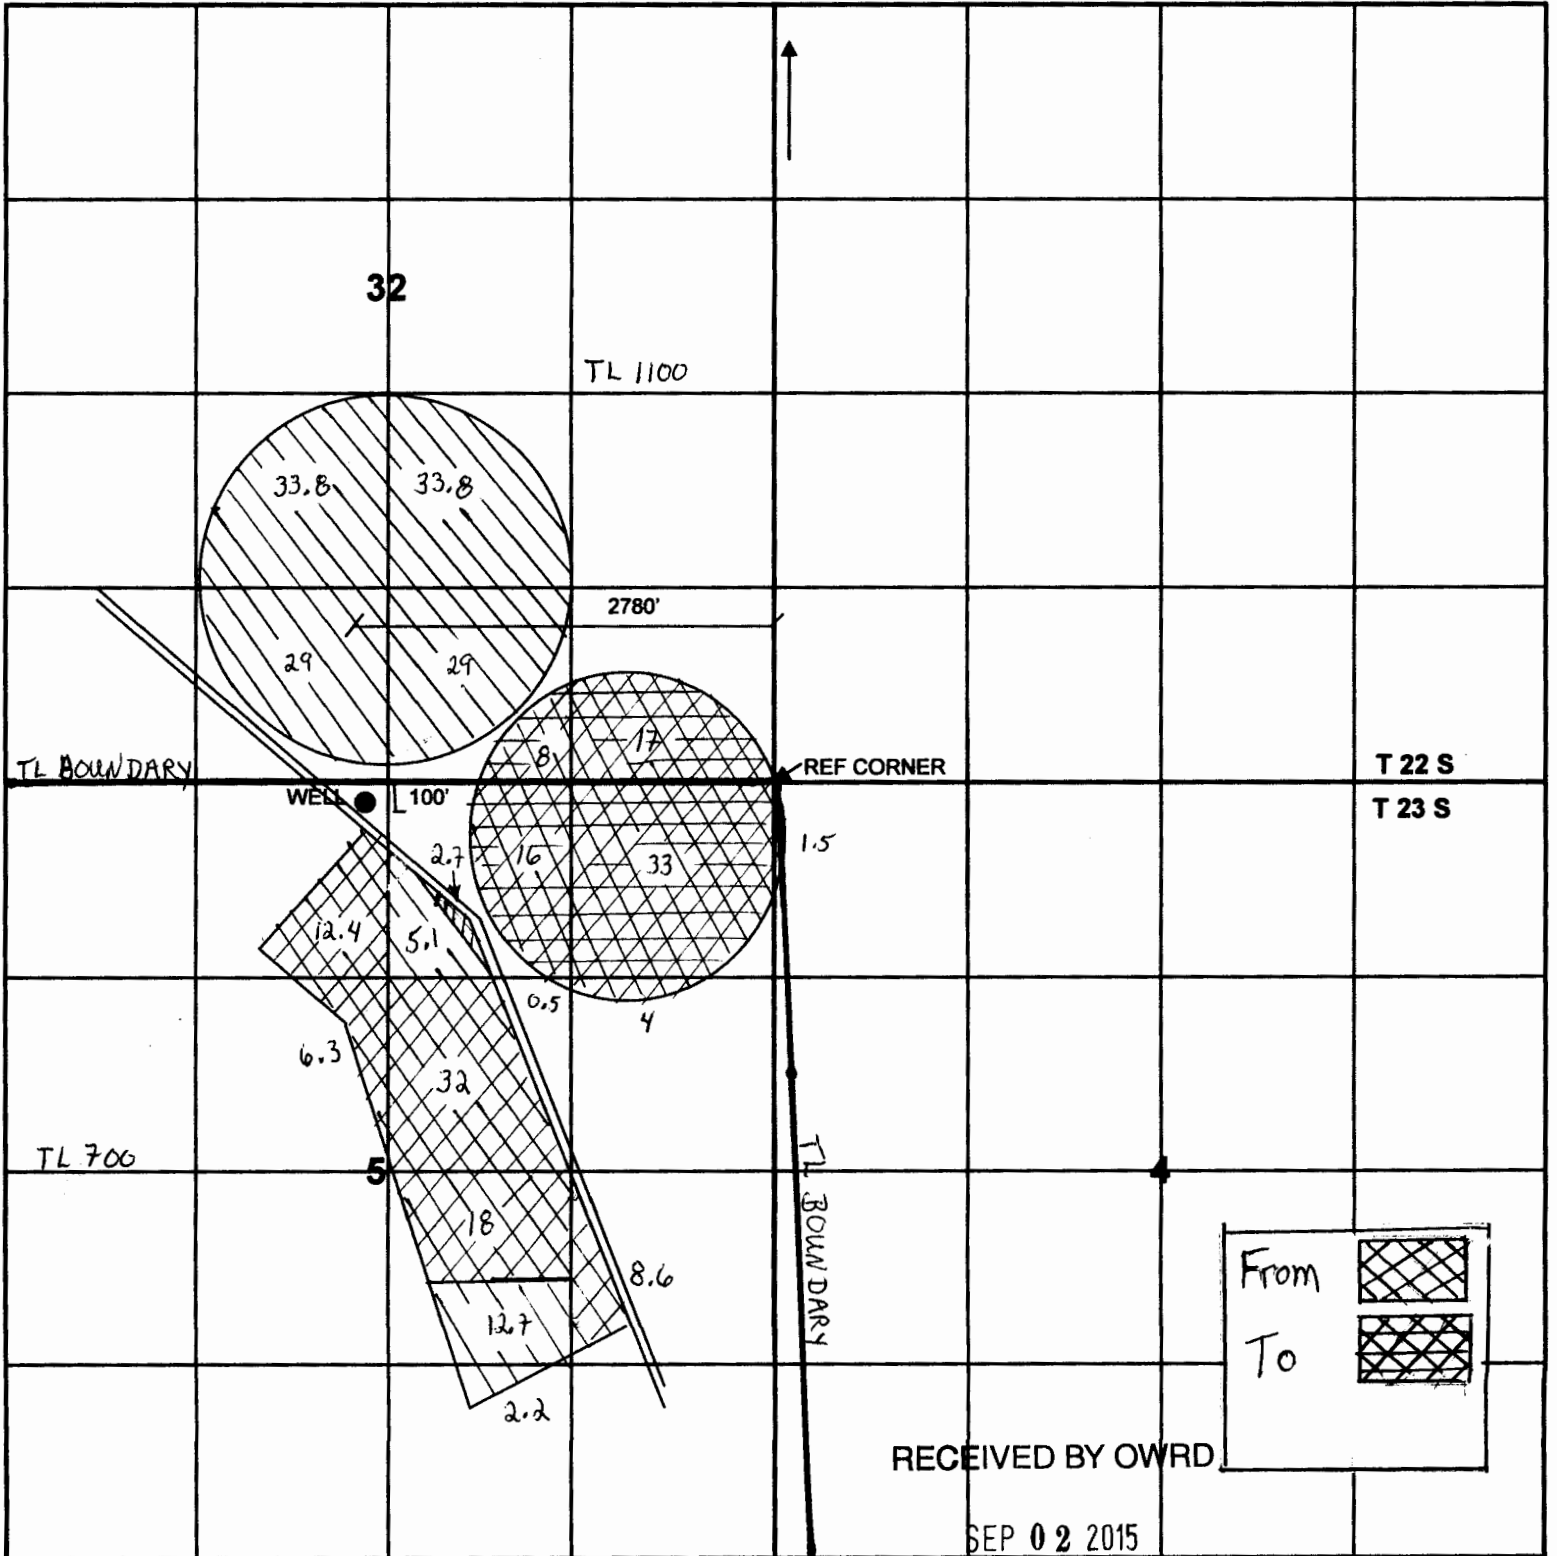
Township 22 S & 23 S



Range 26 E

County of HARNEY

State of OR

NORTH



From   
To 

RECEIVED BY OWRD

SEP 02 2015

4"=1 mile

SALEM, OR

T 12150