

CLAIM OF BENEFICIAL USE MAP FOR GROUND WATER RIGHTS IN THE NAME OF WILLIAM V. HILL




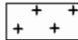
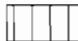
Application # G-13657


Permit # G-12619

LOCATED IN THE SE¼, SEC. 15, N½ NE¼, SEC 22, S½ & NW¼. SEC 23, N½, SEC 26, NE¼NE¼, SEC 27, T. 36S, R. 14E., W.M. KLAMATH COUNTY, OREGON


LEGEND

PRIMARY

-  SUPPLEMENTAL TO CERTIFICATE #9953 & #33926
-  SUPPLEMENTAL TO CERTIFICATE #9964
-  SUPPLEMENTAL TO CERTIFICATE #9974 & #33926
-  SUPPLEMENTAL TO CERTIFICATE #31365
-  SUPPLEMENTAL TO CERTIFICATE #9952, #21416 & #33926
- 10.0 ACREAGE

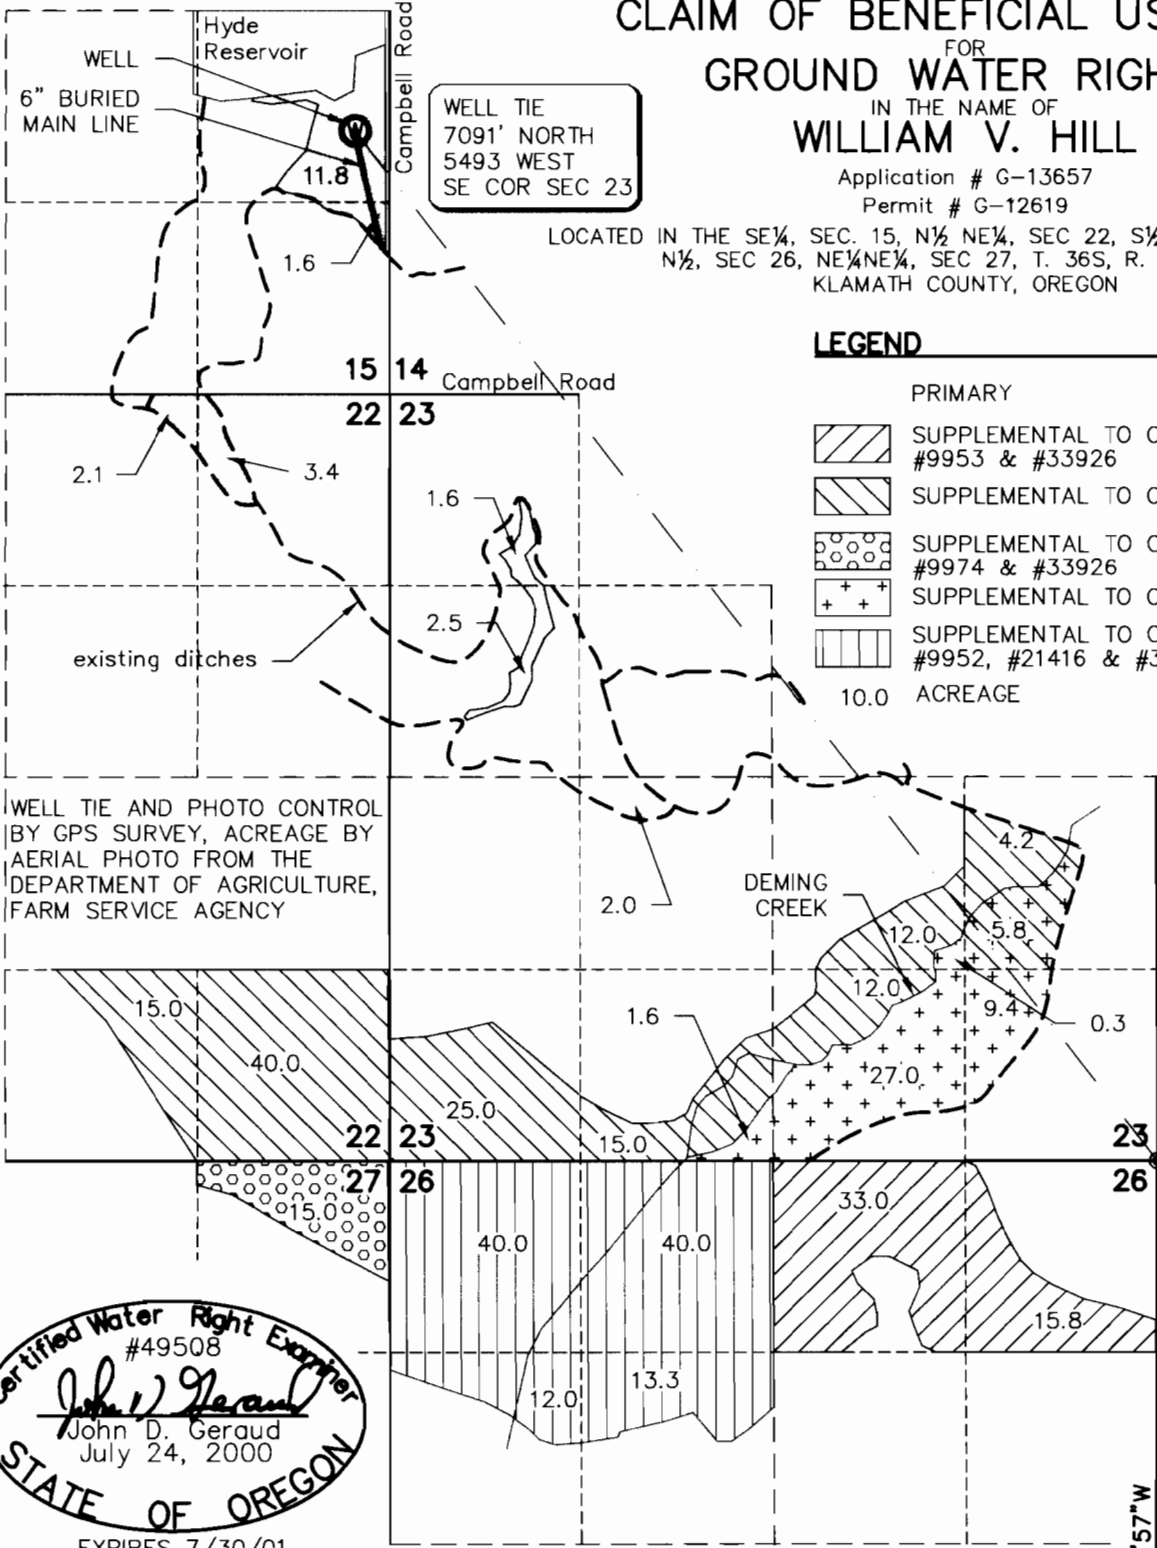

WELL TIE AND PHOTO CONTROL BY GPS SURVEY, ACREAGE BY AERIAL PHOTO FROM THE DEPARTMENT OF AGRICULTURE, FARM SERVICE AGENCY

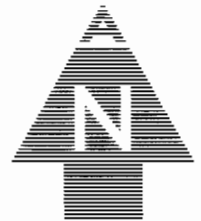

SCALE: 1" = 1320'

Certified Water Right Examiner
#49508
John D. Geraud
John D. Geraud
July 24, 2000
STATE OF OREGON
EXPIRES 7/30/01

RECEIVED

SEP 28 2000

WATER RESOURCES
SALEM, OREGON

ADKINS

CONSULTING
ENGINEERS, INC.

THIS MAP IS FOR THE PURPOSE OF IDENTIFYING THE LOCATION OF THE WATER RIGHT ONLY AND HAS NO INTENT TO PROVIDE DIMENSIONS OR LOCATION OF PROPERTY LINES.

FOUND MONUMENT
PER CS 2162

Engineers ▲ Planners ▲ Surveyors

2950 Shasta Way · Klamath Falls, Oregon 97603 · (541) 884-4666 · FAX (541) 884-5335

September 20, 2000

Klamath Falls, OR · Medford, OR · Alturas, CA

JOB No. 2257-01




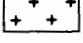
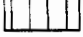
CLAIM OF BENEFICIAL USE MAP FOR GROUND WATER RIGHTS IN THE NAME OF WILLIAM V. HILL

Application # G-13657
Permit # G-12619


LOCATED IN THE SE¼, SEC. 15, N½ NE¼, SEC 22, S½ & NW¼. SEC 23,
N½, SEC 26, NE¼NE¼, SEC 27, T. 36S, R. 14E., W.M.
KLAMATH COUNTY, OREGON

LEGEND


PRIMARY

-  SUPPLEMENTAL TO CERTIFICATE #9953 & #33926
-  SUPPLEMENTAL TO CERTIFICATE #9964
-  SUPPLEMENTAL TO CERTIFICATE #9974 & #33926
-  SUPPLEMENTAL TO CERTIFICATE #31365
-  SUPPLEMENTAL TO CERTIFICATE #9952, #21416 & #33926

10.0 ACREAGE

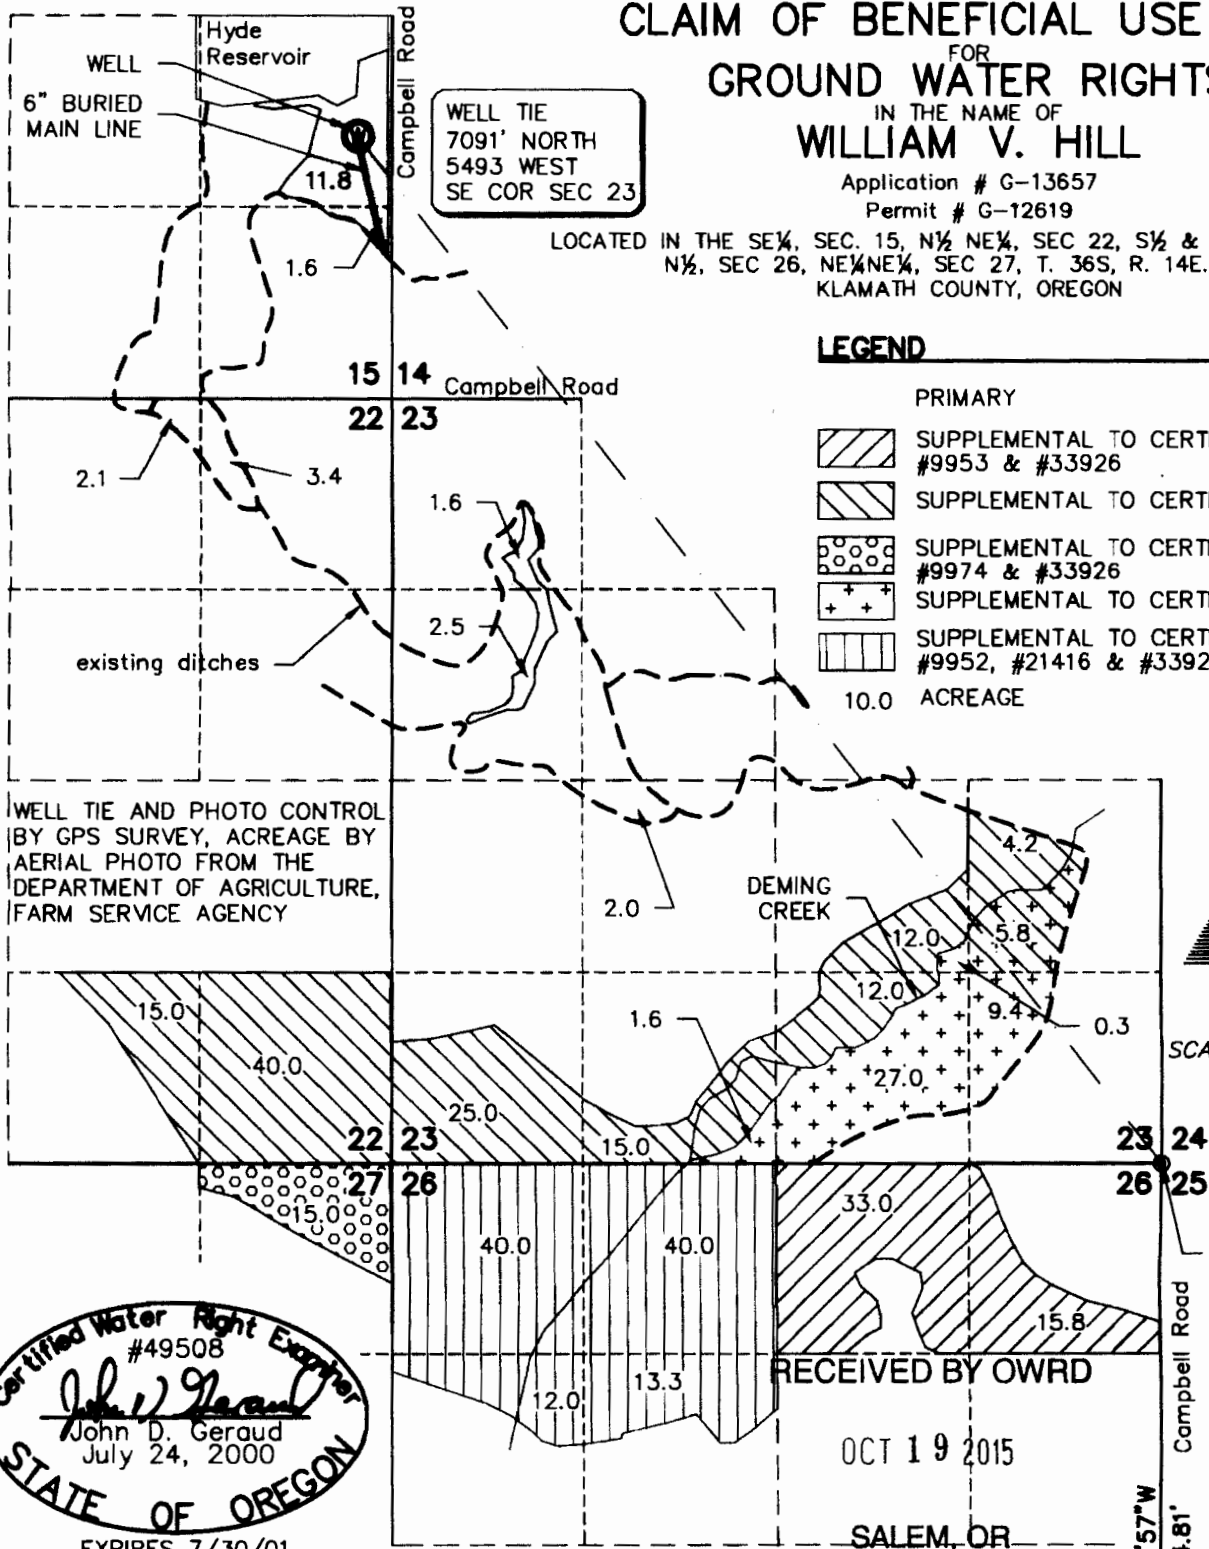

WELL TIE AND PHOTO CONTROL BY GPS SURVEY, ACREAGE BY AERIAL PHOTO FROM THE DEPARTMENT OF AGRICULTURE, FARM SERVICE AGENCY

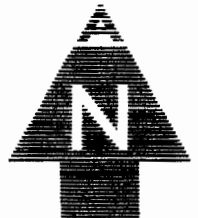

SCALE: 1" = 1320

FOUND MONUMENT PER CS 2431

RECEIVED BY OWRD

OCT 19 2015

SALEM, OR


FOUND MONUMENT PER CS 2162

S00°23'57"W
5354.81'

RECEIVED

SEP 28 2000

WATER RESOURCES DIVISION
SALEM, OREGON

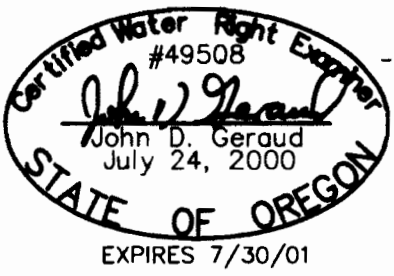

THIS MAP IS FOR THE PURPOSE OF IDENTIFYING THE LOCATION OF THE WATER RIGHT ONLY AND HAS NO INTENT TO PROVIDE DIMENSIONS OR LOCATION OF PROPERTY LINES.

1 12189

Engineers ▲ Planners ▲ Surveyors

CLAIM OF BENEFICIAL USE MAP FOR GROUND WATER RIGHTS






IN THE NAME OF
WILLIAM V. HILL

Application # G-13657
Permit # G-12619

LOCATED IN THE SE $\frac{1}{4}$, SEC. 15, N $\frac{1}{2}$ NE $\frac{1}{4}$, SEC. 22, S $\frac{1}{2}$ & NW $\frac{1}{4}$, SEC. 23,
N $\frac{1}{2}$, SEC. 26, NE $\frac{1}{4}$ NE $\frac{1}{4}$, SEC. 27, T. 36S, R. 14E., W.M.
KLAMATH COUNTY, OREGON


LEGEND

PRIMARY

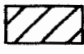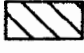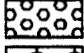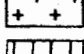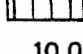-  SUPPLEMENTAL TO CERTIFICATE #9953 & #33926
-  SUPPLEMENTAL TO CERTIFICATE #9964
-  SUPPLEMENTAL TO CERTIFICATE #9974 & #33926
-  SUPPLEMENTAL TO CERTIFICATE #31365
-  SUPPLEMENTAL TO CERTIFICATE #9952, #21416 & #33926

10.0 ACREAGE


 SUPPLEMENTAL TO
CERTIFICATE #9966

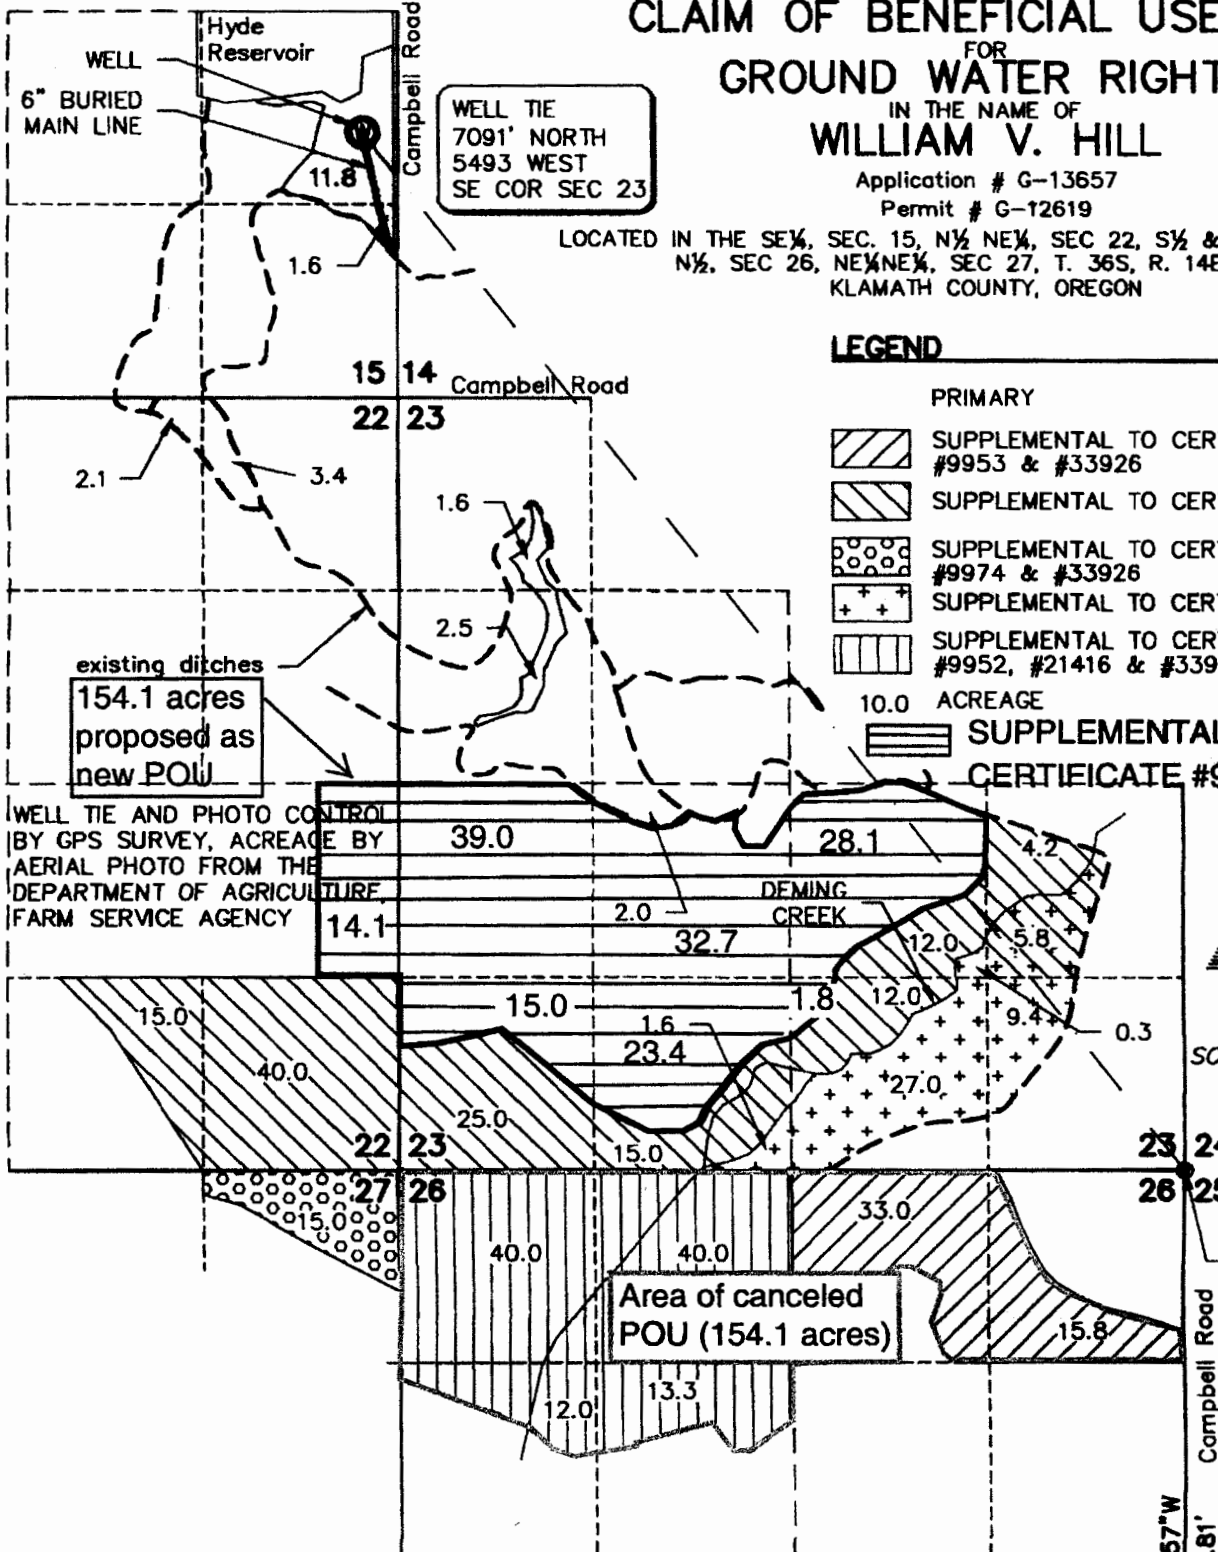

WELL TIE AND PHOTO CONTROL
BY GPS SURVEY, ACREAGE BY
AERIAL PHOTO FROM THE
DEPARTMENT OF AGRICULTURE
FARM SERVICE AGENCY

existing ditches
154.1 acres
proposed as
new POU

Area of canceled
POU (154.1 acres)

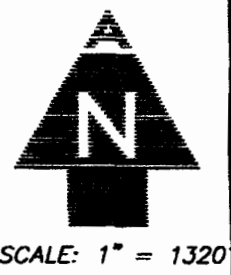

Revised Permit
Application Map
September 8, 2015

THIS MAP IS FOR THE PURPOSE OF
IDENTIFYING THE LOCATION OF THE
WATER RIGHT ONLY AND HAS NO
INTENT TO PROVIDE DIMENSIONS OR
LOCATION OF PROPERTY LINES.

FOUND MONUMENT
PER CS 2162
RECEIVED BY OWRD

OCT 19 2015

SALEM, OR

1 12100