


FOR ASSESSMENT AND TAXATION ONLY

SECTION 11 T.12S. R.4W. W.M.  
Linn County  
1" = 400'

12S04W11  
TANGENT

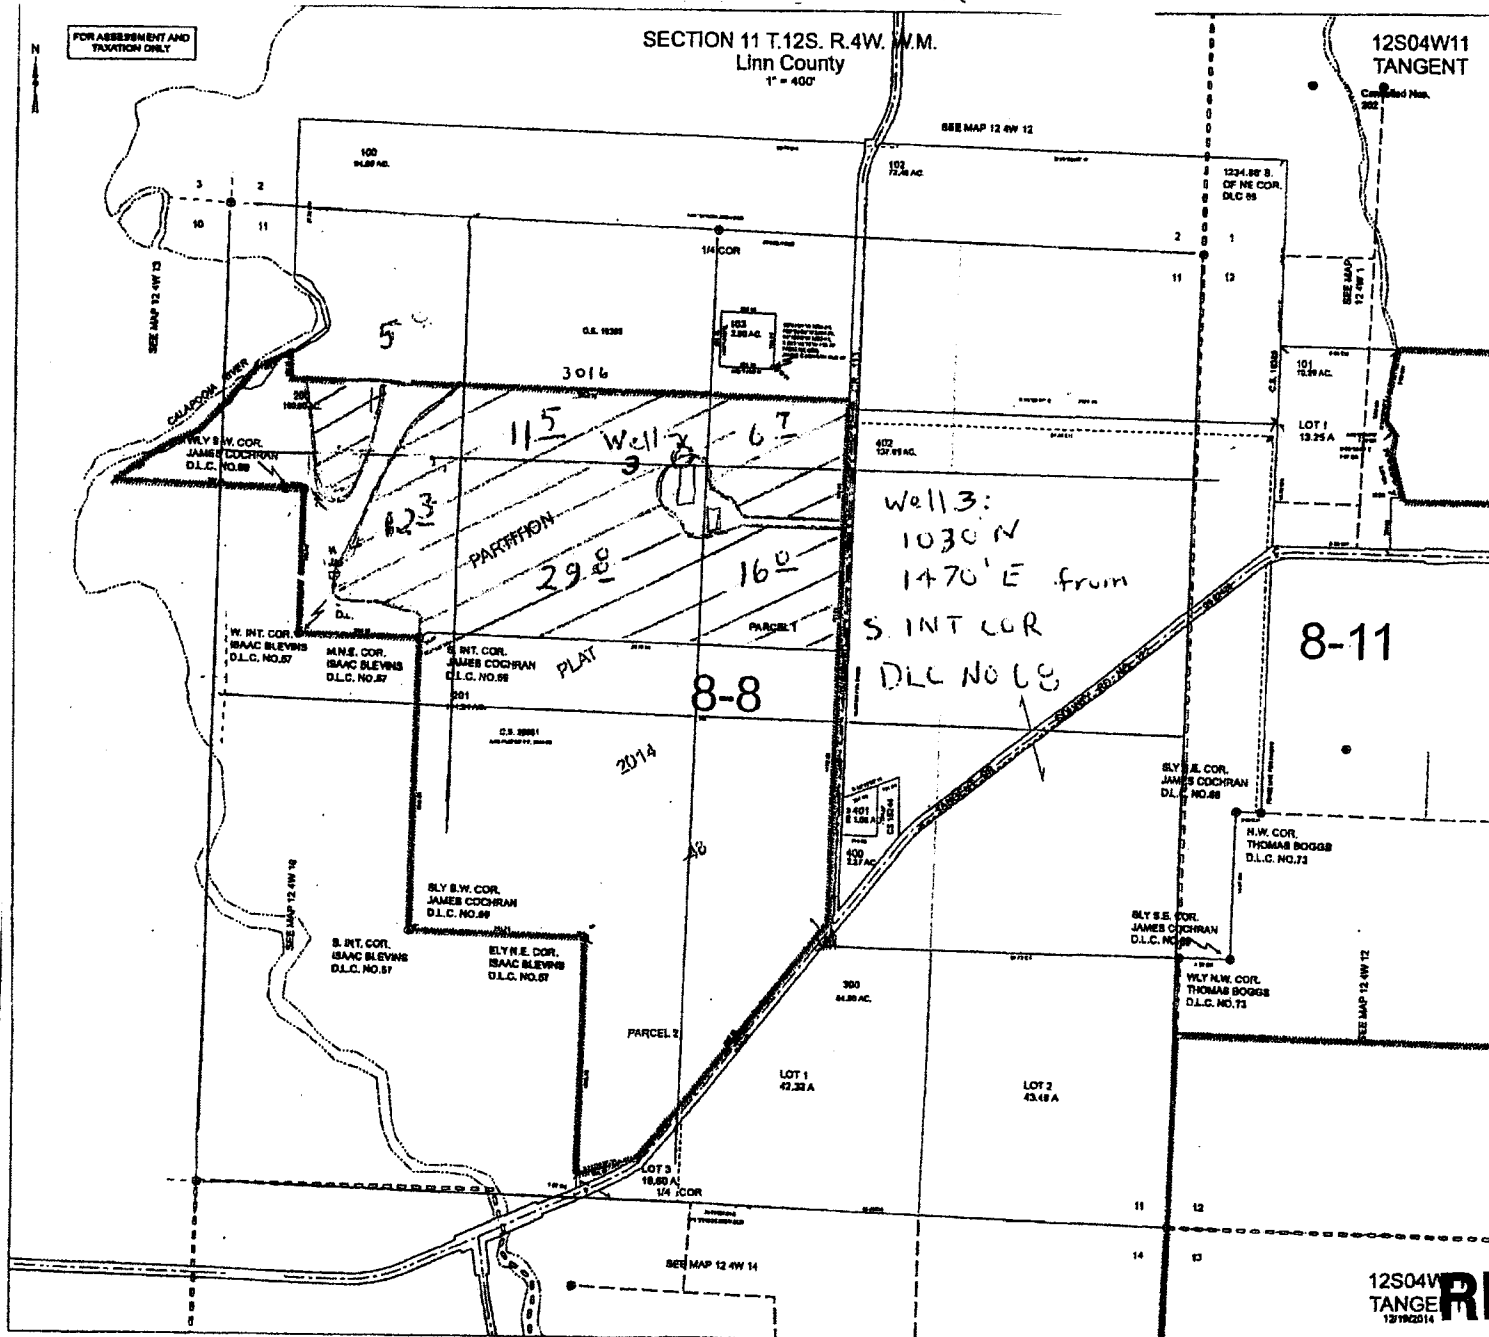

Acres




Henriksen

12S04W  
TANGENT  
12/19/2014

**RECEIVED**

APR 01 2015

WATER RESOURCES DEPT  
SALEM, OREGON