

Map 2 of 2

Ground Water Application


Gerald & Mary Gould
Township 40 South, Range 19 East, WM.

For supplemental irrigation and reservoir maintenance

RECEIVED

AUG 16 2002

WATER RESOURCES DEPT.
SALEM, OREGON

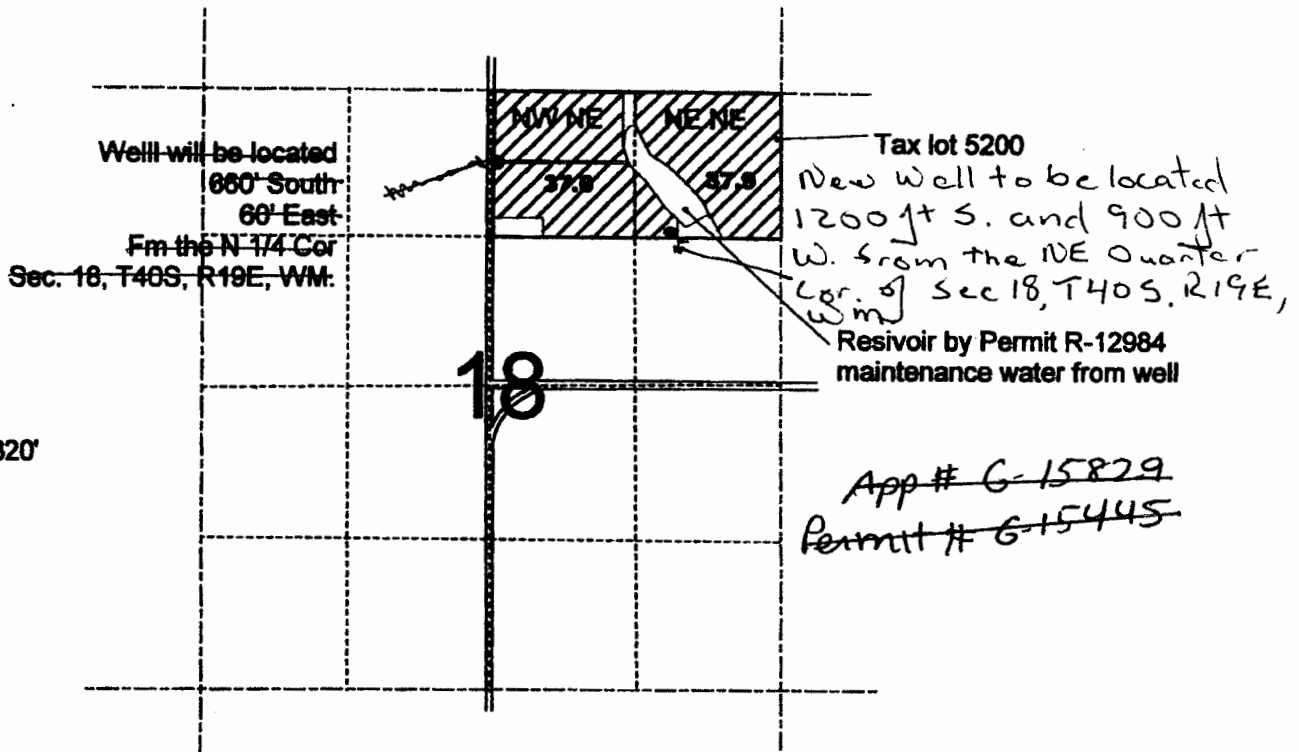

Water will be transported from well
to reservoir by 6" pipeline

RECEIVED BY OWRD

DEC 08 2014

SALEM, OR

Drawn by
Hollie Cannon
Water Right Solutions, LLC
2770 Camp Baker RD.
Medford, OR 97501
541-512-1160