

RECEIVED
 JAN 14 2016
 OWRD

SCALE: 1"=1320'




Lands requesting Supplemental water from new Wells #1 and #2 under Permit G-16263 and having primary water under C-1470, C-1471, and C-1455.

Well # 1 authorized position: 475' N and E 30' from SE, NE, Sec. 2

Well # 2 authorized position: 1260' N, 500' E from NW corner of SE, NE, Sec. 2

Proposed location of well # 2 is S 1560' and W 310' from NE cor Sec. 2. T7S R38E, WM

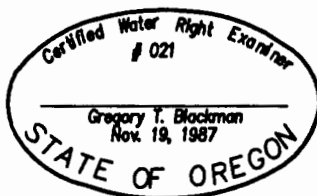

September 21, 2015
MAP OF PROPOSED NEW LOCATION OF WELL #2 G-16263 AS LOCATED BY PHILLIP MARCY FOR PROPOSED WELL # 2

FOR
LOUIS MARKS
 BY

BAGETT - GRIFFITH & BLACKMAN
 128 RIDGE DRIVE
 LAGRANDE, OREGON 97850

Application No. _____
 Permit Number T-12041

NOTE: The preparation of this map was for the purpose of identifying the location of the proposed water right and has no intent to provide dimensions or location of property ownership lines. Location information shown hereon was furnished by the applicant.