

SECTION PLAT

Section 2, 3, 10, 11


Township 39

Range 37

County of Harney

State of OR

NORTH

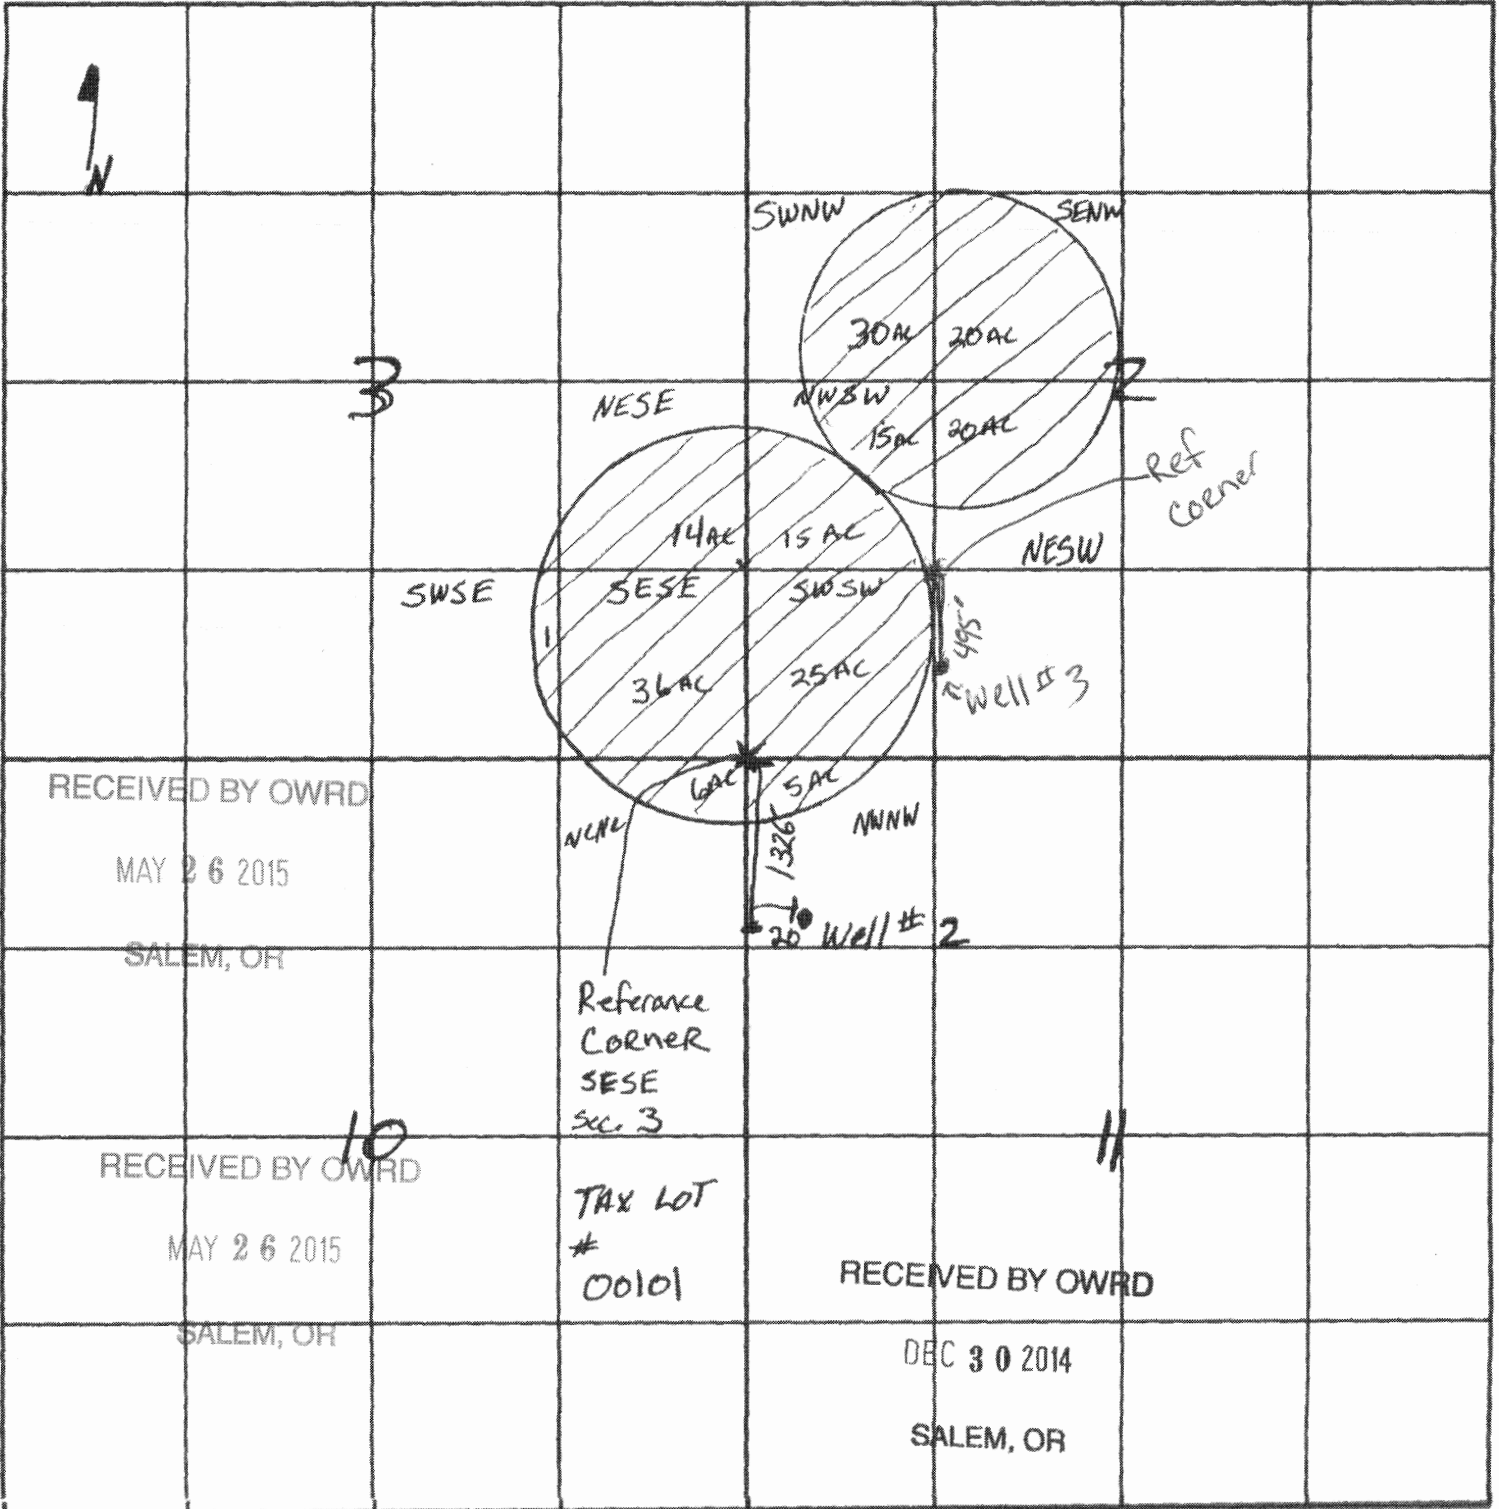

G-17979

4" = 1 mile