


PRIVE  
 3483 DEERWOOD DRIVE  
 EUGENE, OR 97405


OREGON  
 00'  
 FEETS

For iron pipe marking  
 the east 1/4 corner of  
 Sec. 25 - T18S - R3W - W.M.

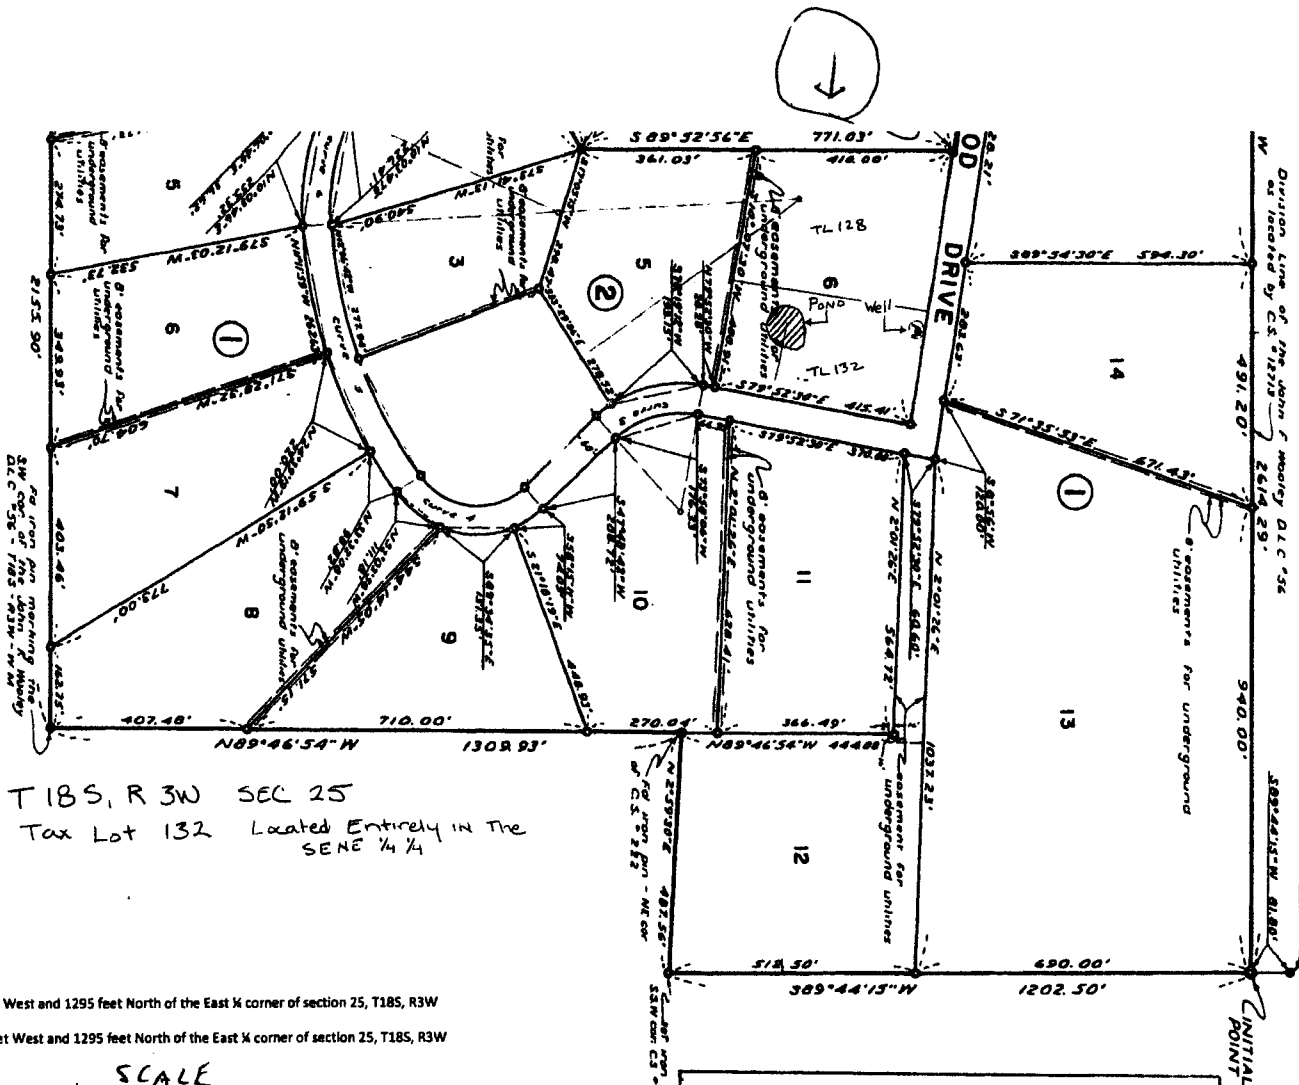


T18S, R3W SEC 25  
 Tax Lot 132 Located Entirely in the  
 SENE 1/4

Well located 690 feet West and 1295 feet North of the East 1/4 corner of section 25, T18S, R3W  
 Pond Located 965 Feet West and 1295 feet North of the East 1/4 corner of section 25, T18S, R3W

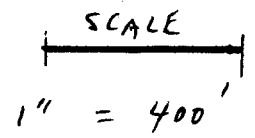

ENLARGEMENT  
 OF  
 SUBJECT  
 PROPERTY

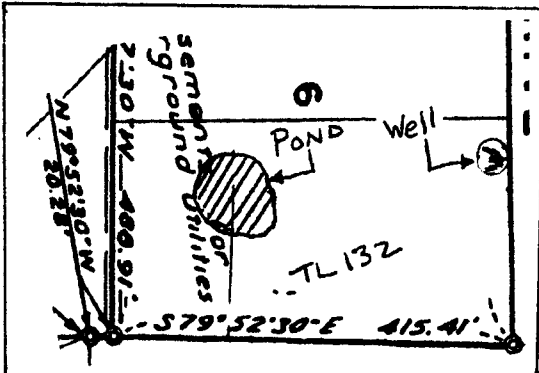

RECEIVED BY OWRD

APR 24 2015

SALEM, OR

6-18060