



T23S, R26E, SECTIONS 11 & 12, WM
HARNEY COUNTY, OREGON

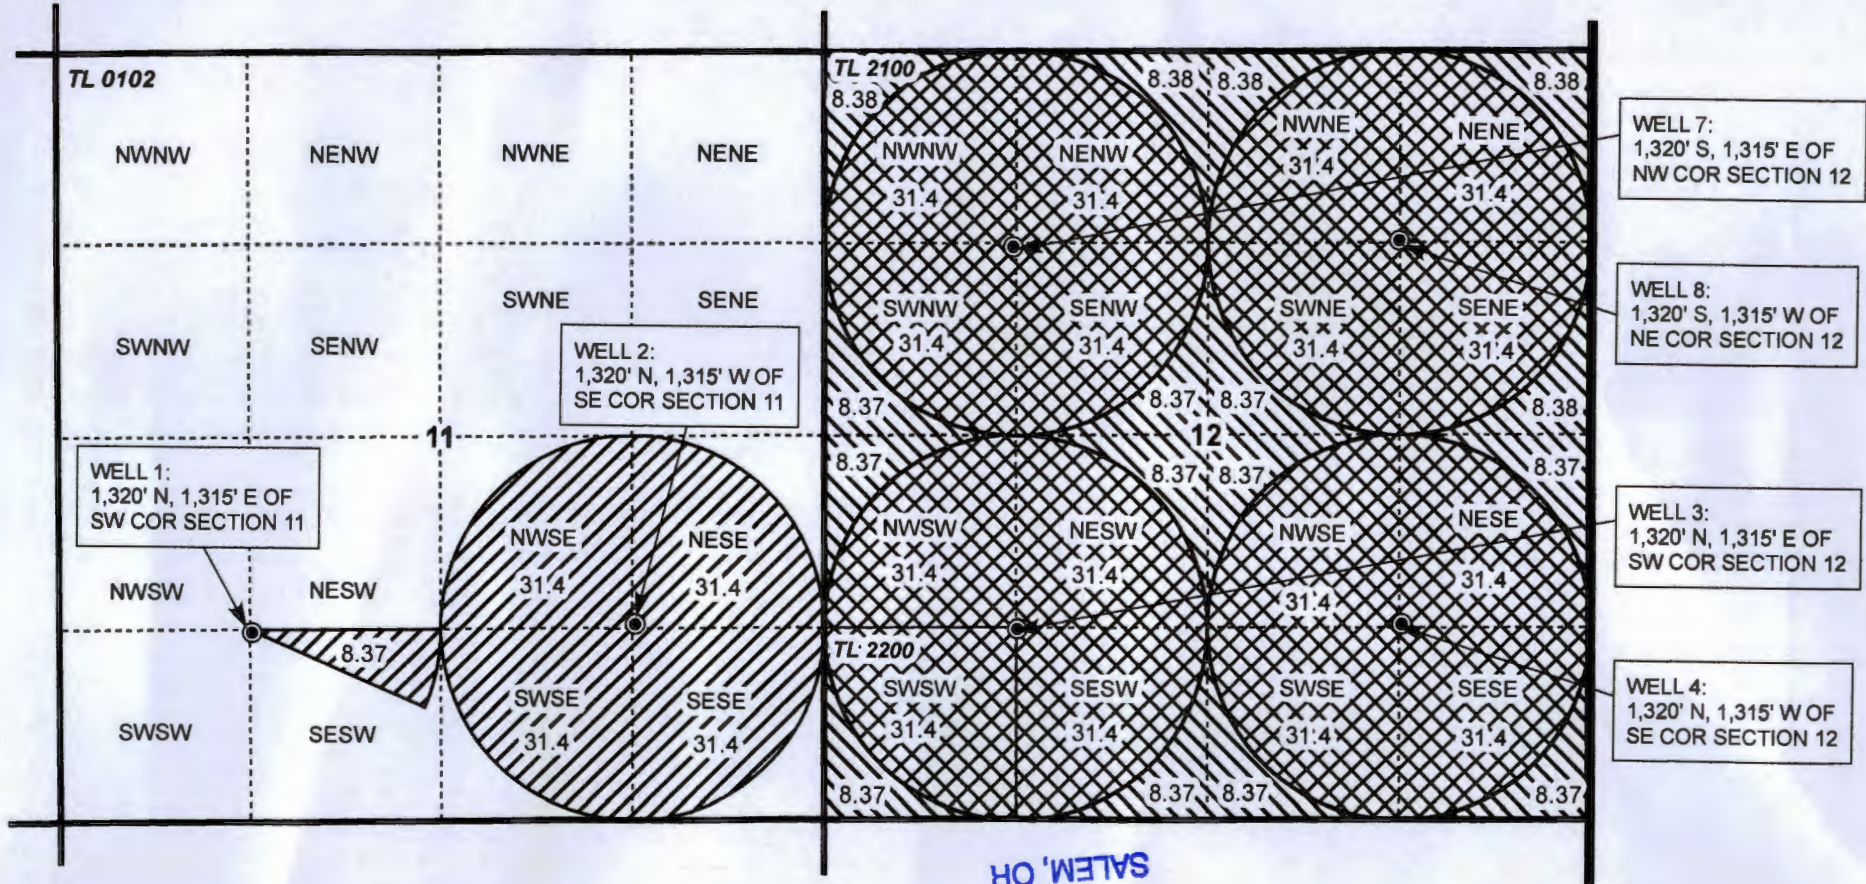

- POU Irrigation, On
- POU Irrigation, Off
- POU Irrigation, Remaining
- Township
- Section
- Quarter Quarter
- Taxlot
- Well

RECEIVED BY OWRD
 AUG 17 2015
 SALEM, OR

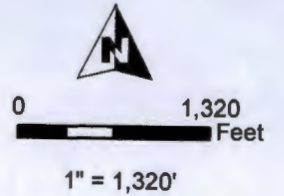

RENEWAL DATE 12/31/2015

PERMIT AMENDMENT MAP
Golden Rule Farms, Inc.
 T 12136
 PERMIT G-17062

NOTE: THIS MAP IS NOT INTENDED TO
 PROVIDE LEGAL DIMENSIONS OR LOCATIONS
 OF PROPERTY OWNERSHIP LINES.
 AUGUST 5, 2015

WATER RIGHT SERVICES, LLC
 PO BOX 1830, BEND, OR 97709
 CCB# 197121 www.oregonwater.us
 541-389-2837 JOHNSHORT@USA.COM