


Oregon Water Rights Map

September 14, 2015

T-235 R-39E

Oregon Water Resources Department
725 Summer St NE, Suite A, Salem, OR 97301
(503)986-0900

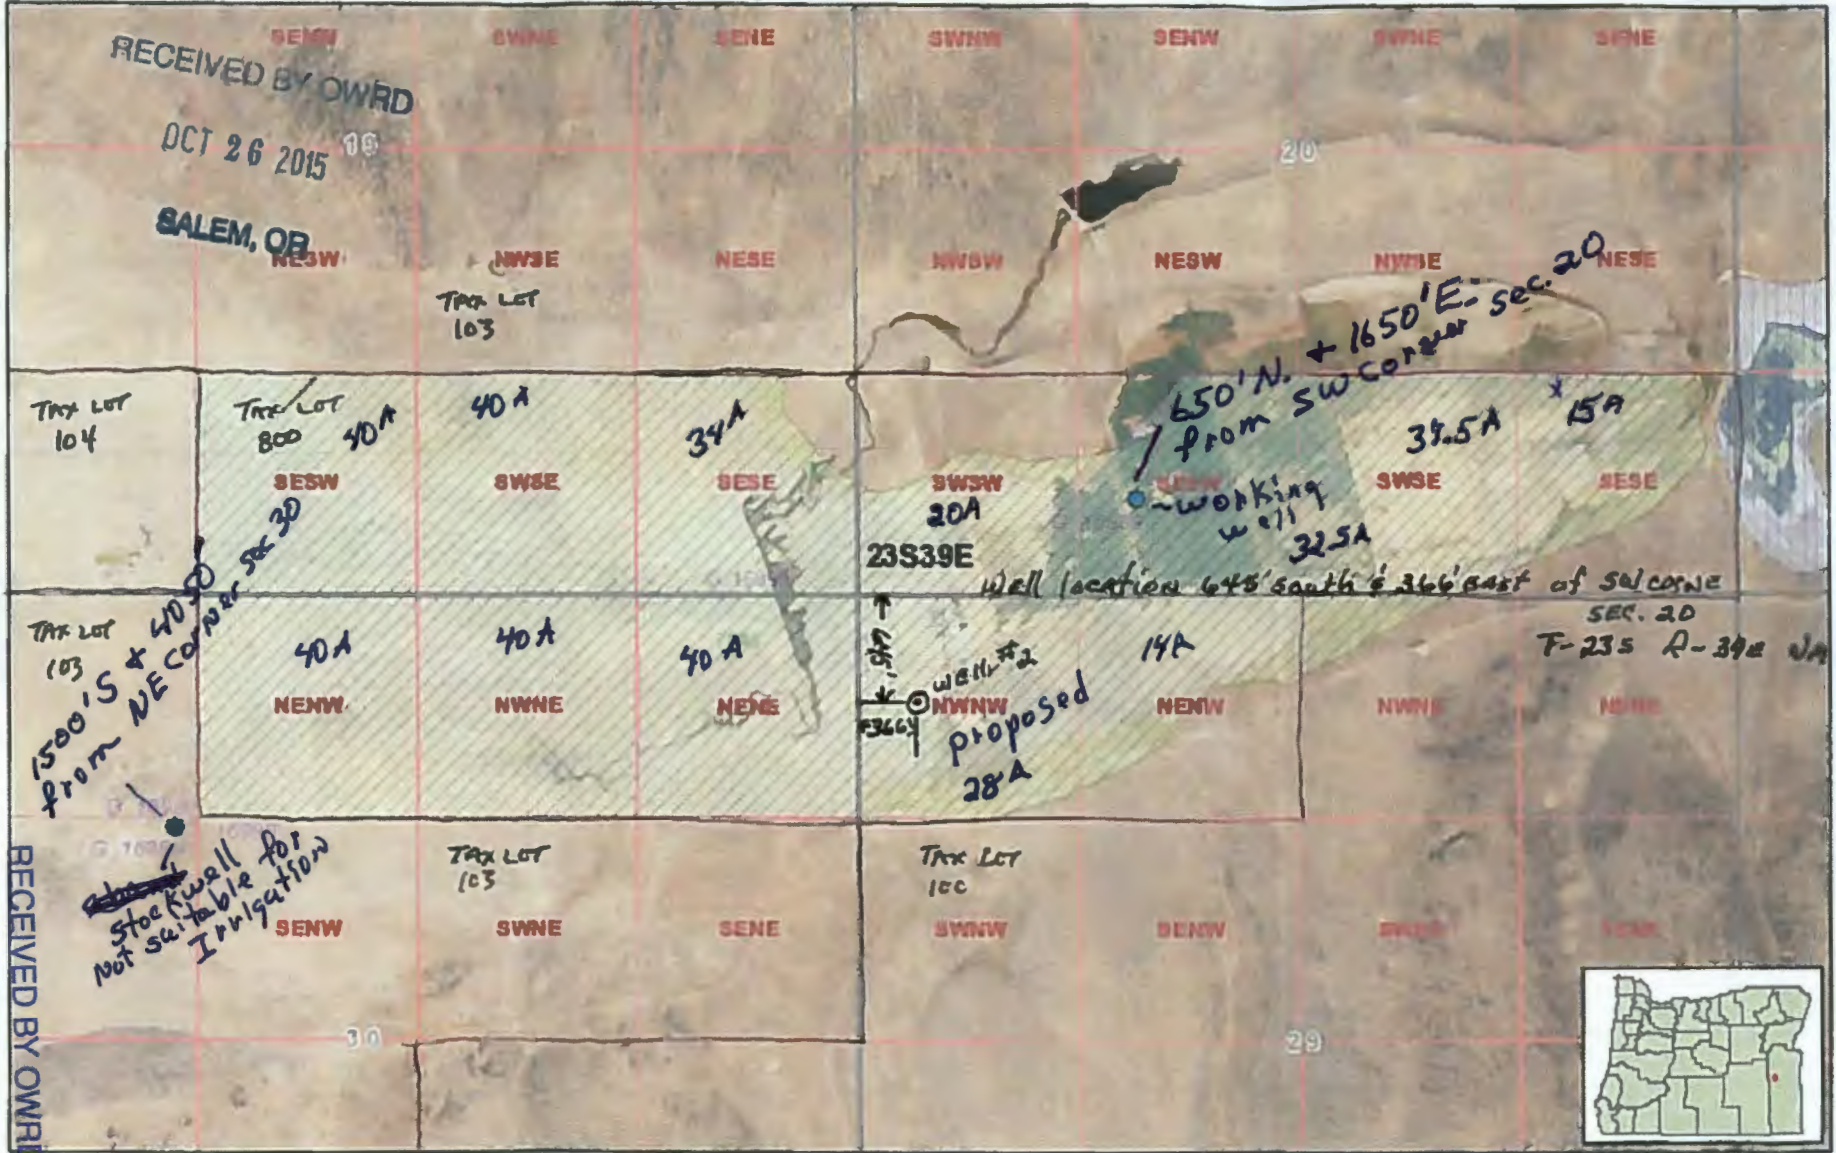

Water Rights by Type


- Point of Diversion
- Surface Water
- Surface Water
- Groundwater

Water Rights by Use

- Recreation
- Fish
- Wildlife
- Residential
- Inst.
- Agriculture
- Livestock
- Irrigation
- Mining

By Primary/Supplemental

- Power
- Commercial
- Domestic
- Primary
- Supplemental

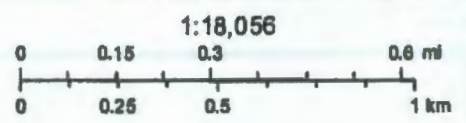

Disclaimer: <http://www.oregon.gov/owrd/pages/MAPS/index.aspx#Disclaimer>

Joe M. Day July 21, 2016 *actually 13A


AUG 12 2016
SALEM, OR

Oregon Water Rights Map

September 14, 2015

T-23S R-39E

Oregon Water Resources Department
725 Summer St NE, Suite A, Salem, OR 97301
(503)986-0900

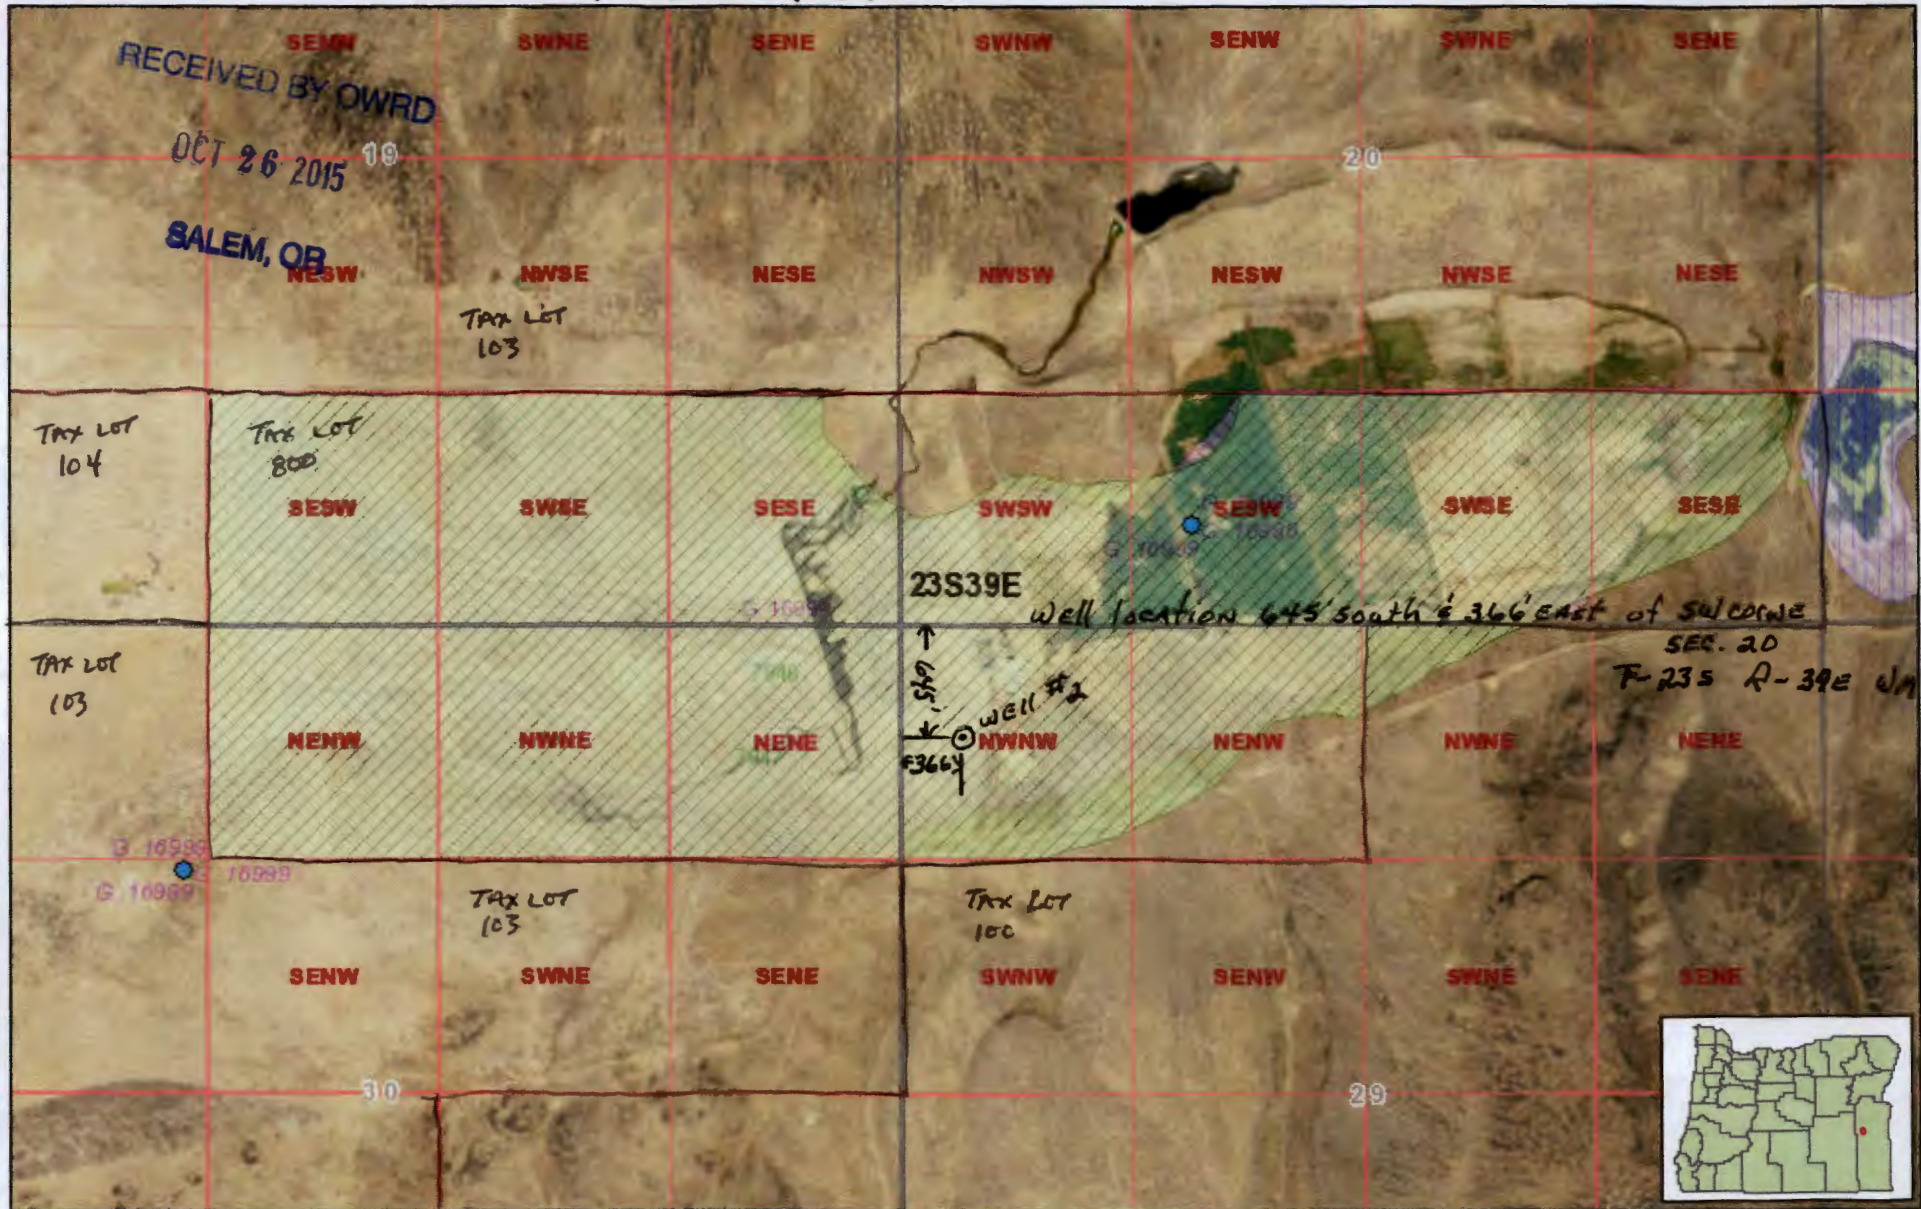

Water Rights by Type

- Point of Diversion
- Surface Water
- Surface Water
- Groundwater


Water Rights by Use

- Recreation
- Fish
- Wildlife

By Primary/Supplemental

- Power
- Commercial
- Domestic
- Primary
- Supplemental

1:18,056

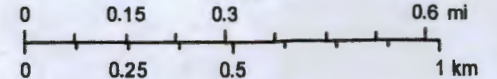

T 12191