

RECEIVED BY OWRD

JUL 27 2015

SALEM, OR

Map to accompany a ground water Permit Amendment
in the name of
Fay Brewster
Permit G-16462



Taxlot boundary



Primary rights applied for from well
9.9 ac




Lands to be irrigated from well
for Supplemental Irrigation
Primary right from Cert. 1518
107.57 ac



Scale: 1" = 440'

T.7S, R. 38 E

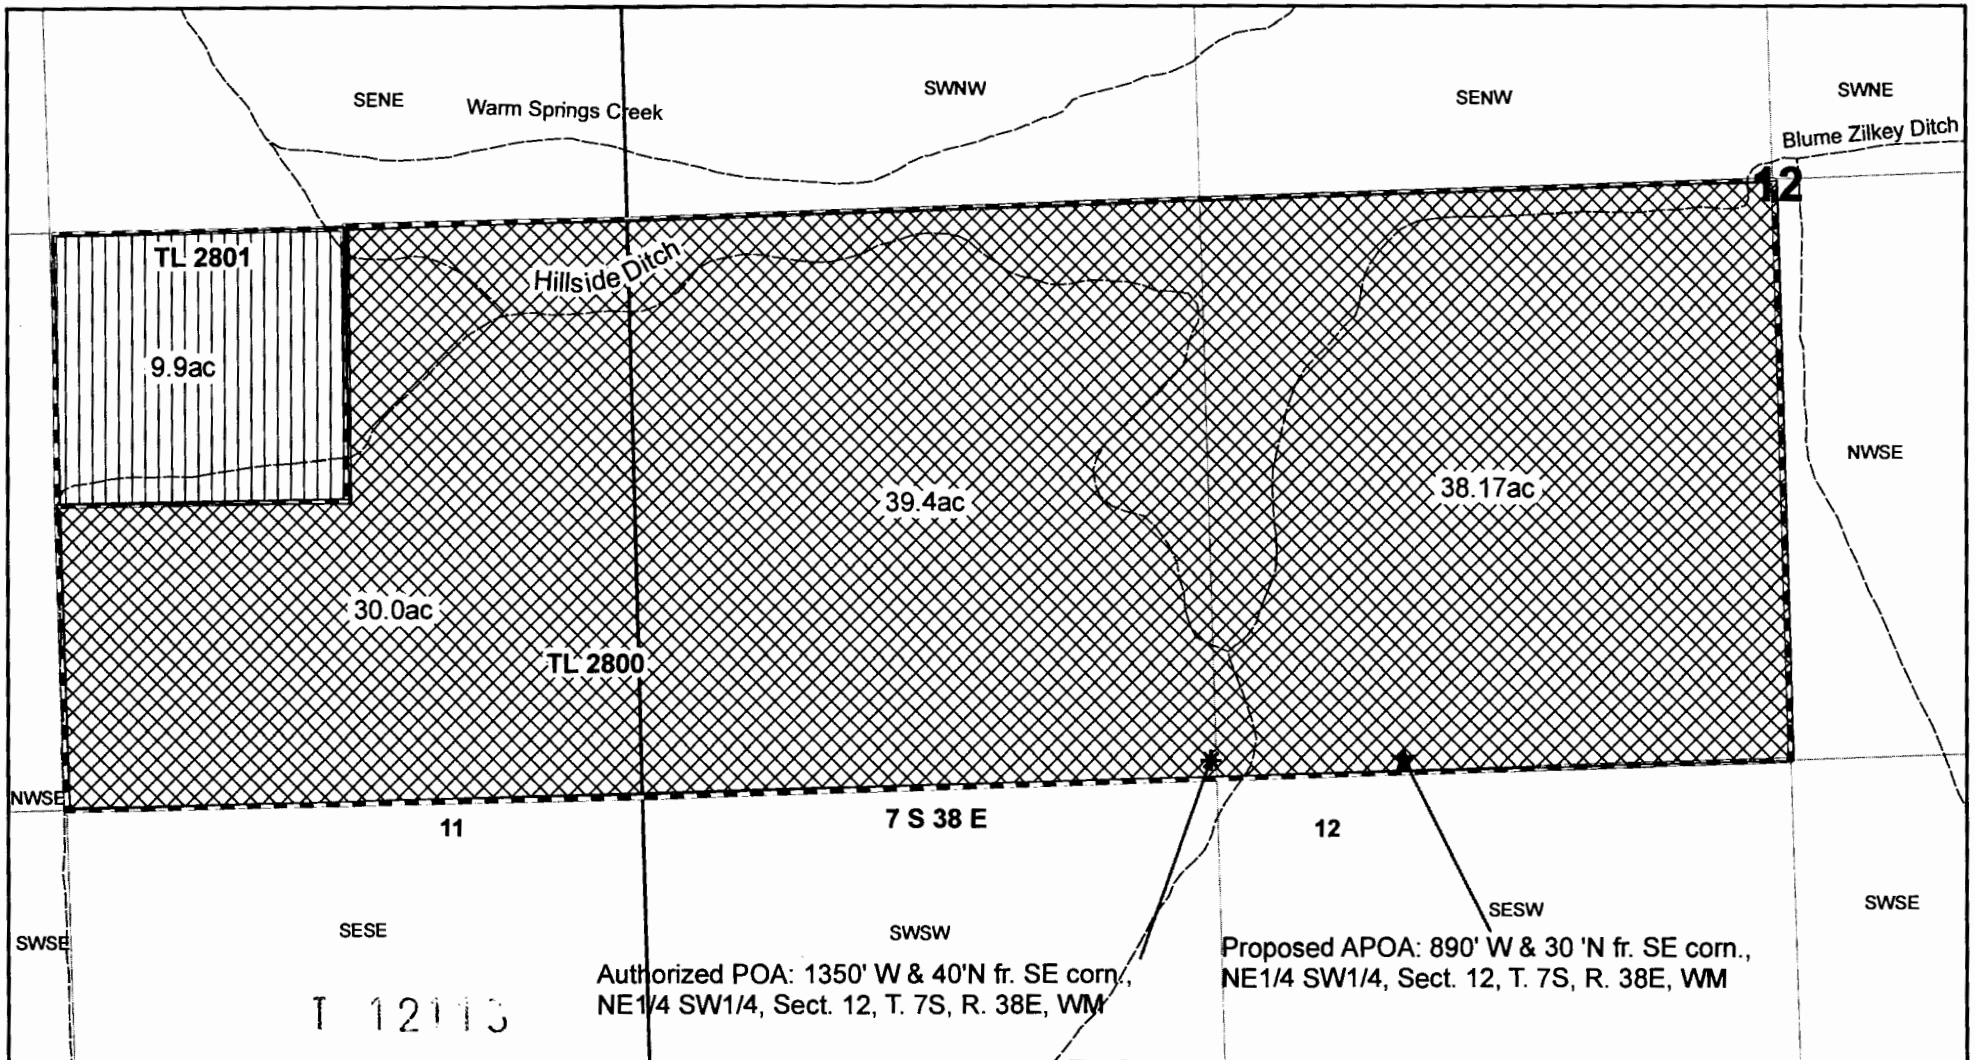

Authorized POA: 1350' W & 40' N fr. SE corn.,
NE 1/4 SW 1/4, Sect. 12, T. 7S, R. 38E, WM

Proposed APOA: 890' W & 30' N fr. SE corn.,
NE 1/4 SW 1/4, Sect. 12, T. 7S, R. 38E, WM