








PREPARATION OF THIS MAP IS FOR THE PURPOSE OF IDENTIFYING THE LOCATION OF THE WATER RIGHT ONLY. THERE IS NO INTENT TO PROVIDE DIMENSIONS OR LOCATIONS OF PROPERTY OWNERSHIP LINES.

**LEGEND**

-  AUTHORIZED PLACE OF USE - PRIMARY (88.3 ACRES)
-  AUTHORIZED PLACE OF USE - SUPPLEMENTAL (304.1 ACRES)
-  WELL: BAKE 55212 / L-101882
-  WELL: BAKE 52264 / L-109663
-  REFERENCE CORNER
-  TAXLOT BOUNDARY
-  SECTION
-  QUARTER-QUARTER

**WELL LOCATIONS:**

"WELL 1" (BAKE 55212 / L-101882): LOCATED APPROXIMATELY 37 FEET SOUTH & 325 FEET WEST OF THE REFERENCE CORNER.

"APOA" (BAKE 52264 / L-109663): LOCATED APPROXIMATELY 466 FEET SOUTH & 295 FEET WEST OF THE REFERENCE CORNER.

REFERENCE CORNER:  
LOCATED AT THE NE CORNER OF SECTION 19, TOWNSHIP 11 SOUTH, RANGE 43 EAST, W.M.

RECEIVED BY OWRD

DEC 14 2015

T 12219

1 INCH = 1,320 FEET




Washington  
Issaquah | Bellingham | Seattle

Oregon  
Portland | Bend | Baker City

California  
Oakland | Sacramento | Irvine


**FARALLON**  
CONSULTING

Quality Service for Environmental Solutions | farallonconsulting.com

**PERMIT AMENDMENT MAP**

BERT SIDDOWAY  
APPLICATION G-17213  
PERMIT G-16783  
DURKEE, OREGON

FARALLON PN: 1524-001

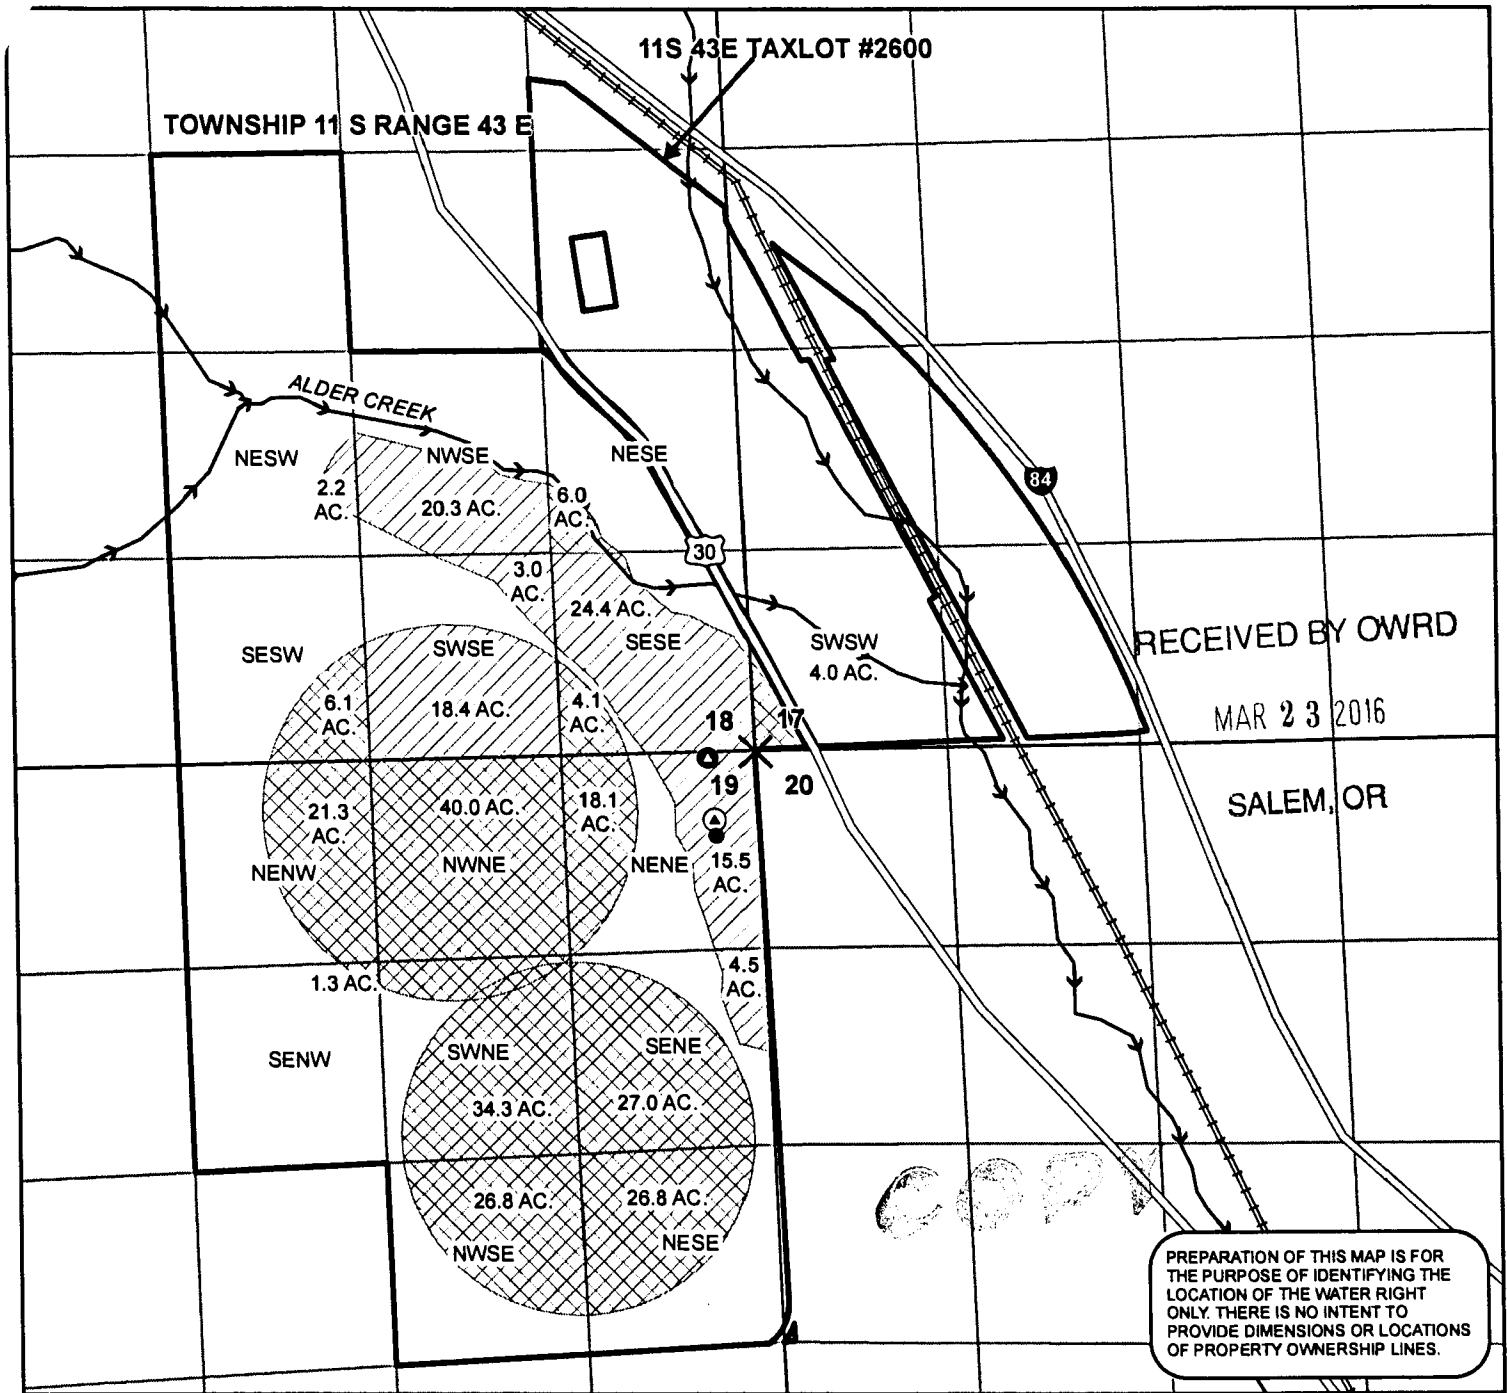

**LEGEND**

- AUTHORIZED PLACE OF USE - PRIMARY (88.3 ACRES)
- AUTHORIZED PLACE OF USE - SUPPLEMENTAL (304.1 ACRES)
- WELL: BAKE 55212 / L-101882
- WELL: BAKE 52264 / L-109663
- REFERENCE CORNER
- TAXLOT BOUNDARY
- SECTION
- QUARTER-QUARTER
- AUTHORIZED POA

**WELL LOCATIONS:**

"WELL 1" (BAKE 52212 / L-101882): LOCATED APPROXIMATELY 37 FEET SOUTH & 325 FEET WEST OF THE REFERENCE CORNER.

"APOA" (BAKE 52264 / L-109663): LOCATED APPROXIMATELY 466 FEET SOUTH & 295 FEET WEST OF THE REFERENCE CORNER.

REFERENCE CORNER:  
LOCATED AT THE NE CORNER OF SECTION 19, TOWNSHIP 11 SOUTH, RANGE 43 EAST, W.M.

PREPARATION OF THIS MAP IS FOR THE PURPOSE OF IDENTIFYING THE LOCATION OF THE WATER RIGHT ONLY. THERE IS NO INTENT TO PROVIDE DIMENSIONS OR LOCATIONS OF PROPERTY OWNERSHIP LINES.

1 INCH = 1,320 FEET



**FARALLON CONSULTING**  
Quality Service for Environmental Solutions | farallonconsulting.com

Washington  
Issaquah | Bellingham | Seattle

Oregon  
Portland | Bend | Baker City

California  
Oakland | Sacramento | Irvine

**PERMIT AMENDMENT MAP**  
BERT SIDDOWAY  
APPLICATION G-17213  
PERMIT G-16783  
DURKEE, OREGON

FARALLON PN: 1524-001