


T24S, R33E, SECTION 18
HARNEY COUNTY, OREGON

ACCEPTED
 4-22-2016 *mt*



- POU Irrigation
- Township
- Section
- Quarter Quarter
- Tax Lot
- Well

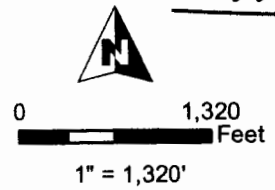


RENEWAL DATE 12/31/2016

RECEIVED BY OWRD
 FEB 11 2016
 SALEM, OR
 13

RECEIVED BY OWRD
 JUN 15 2016
 SALEM, OR

WELL:
 #2: 32' N AND 28.7' W OF SE COR
 OF NW 1/4 OF NE 1/4 OF SEC 18
 #3: 42.7' S AND 32.9' W OF NE COR
 OF SW 1/4 OF SE 1/4 OF SEC 18
 #4: 60.5' N AND 304.75' E OF SW COR
 OF NE 1/4 OF SW 1/4 OF SEC 18
 Max Cumulative Rate = 5.6 cfs

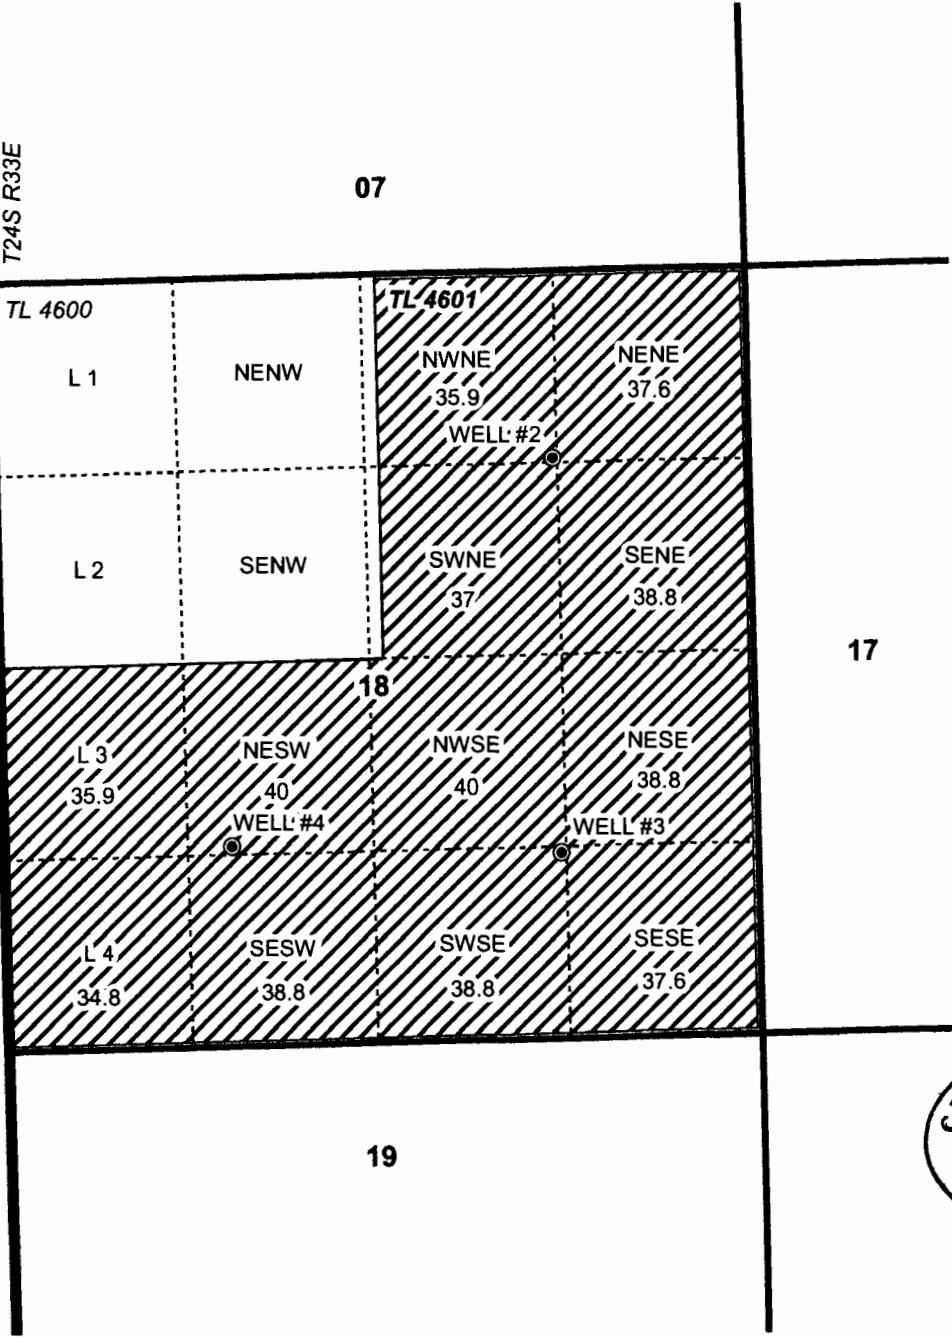

PERMIT SPLIT MAP
Matthew Stashin

NOTE: THIS MAP IS NOT INTENDED TO
 PROVIDE LEGAL DIMENSIONS OR LOCATIONS
 OF PROPERTY OWNERSHIP LINES.

WATER RIGHT SERVICES, LLC
 PO BOX 1830, BEND, OR 97709
CCB# 197121 www.oregonwater.us
 541-389-2837 JOHNSHORT@USA.COM