


T.5S.R.3W.W.M.

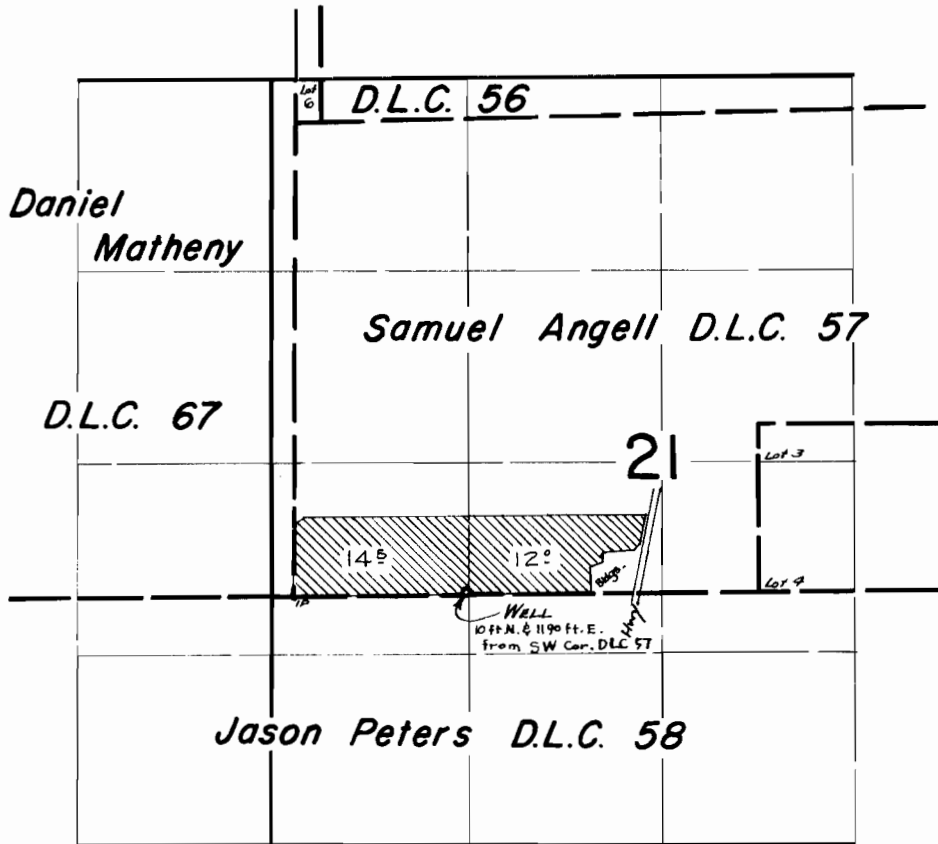

FINAL PROOF SURVEY
UNDER

Application No. G-1915 Permit No. G-1760
IN NAME OF

EMMA M. & WALTER L. DORMAN

Surveyed August 5, 1964, by *A. Jackson*