105 ~~5~~W 25
~~3~~W 30

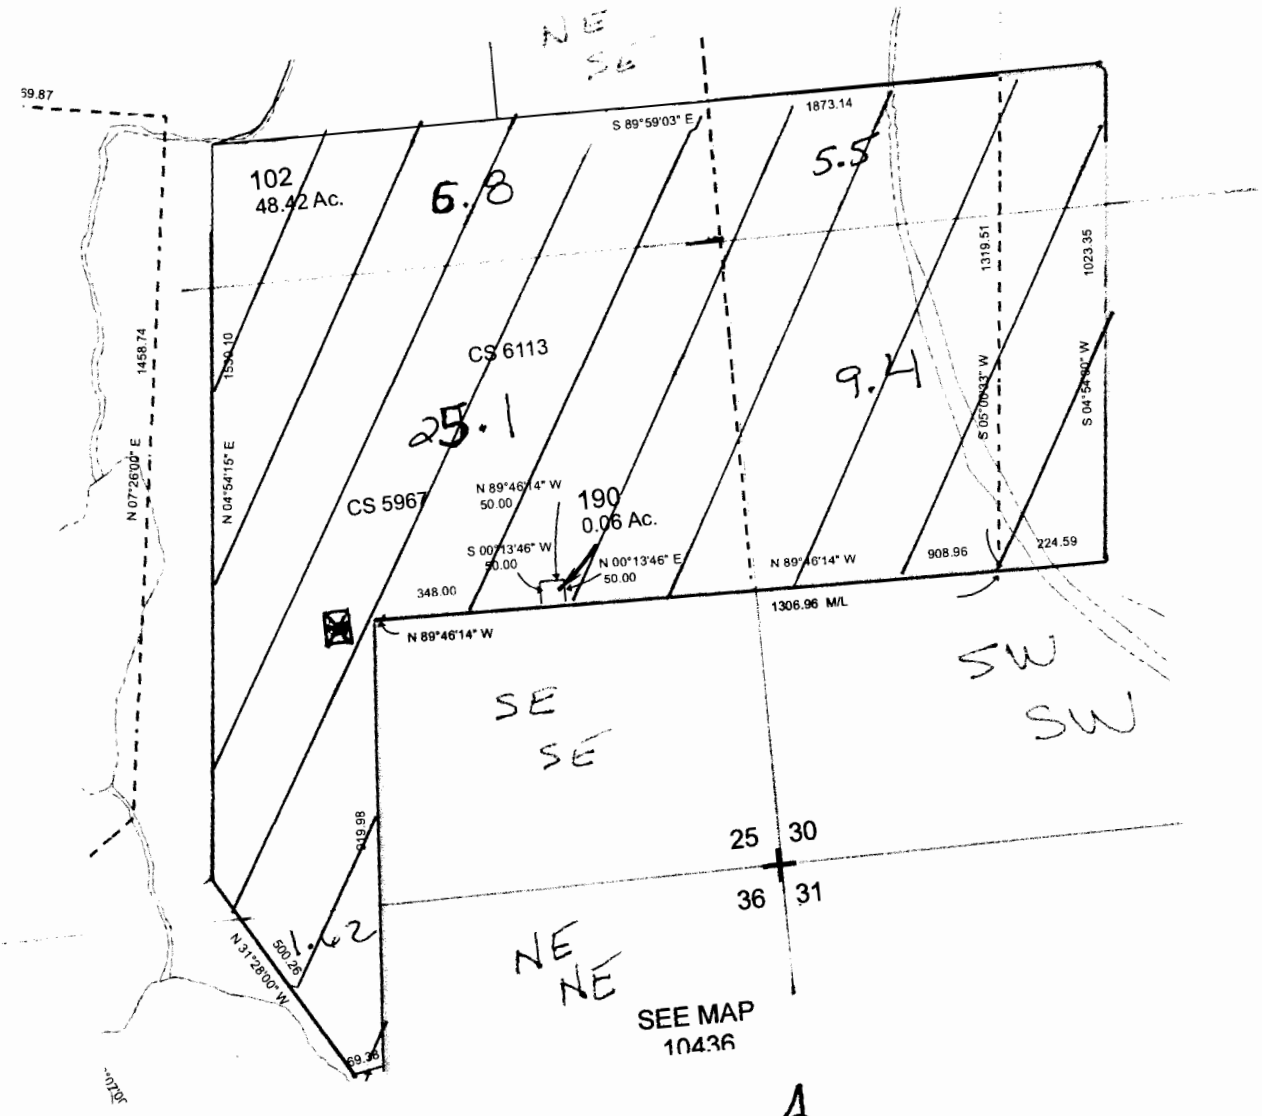

= WELL
580' N and
860' W of
SW corner
of Section 30
T 10S R 4W

RECEIVED
SEP 03 2015
WATER RESOURCES DEPT
SALEM, OREGON

G-18126