


SECTION PLAT

Section 5 Township 25-S Range 33-E

County of Harney State of Oregon

NORTH

G-17168

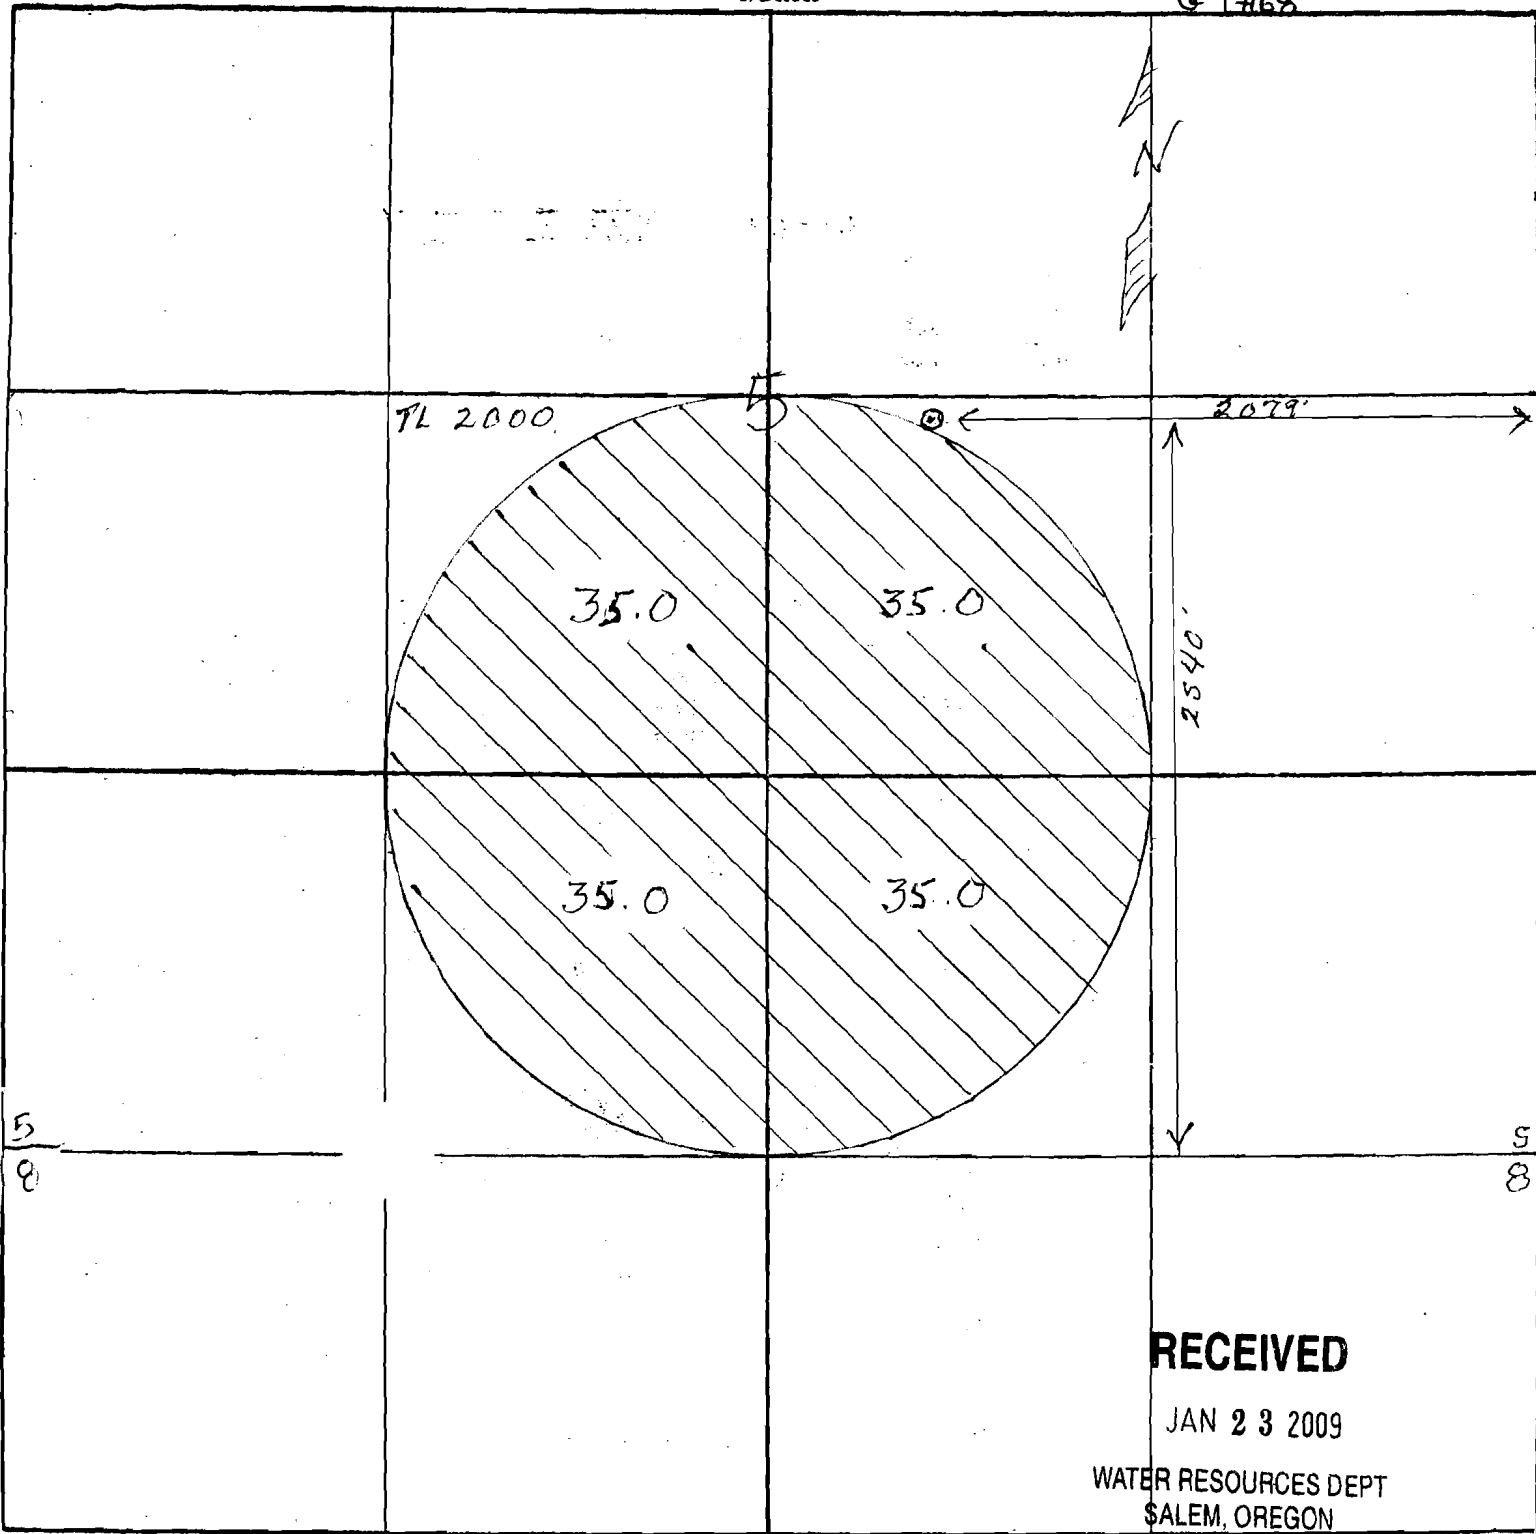

**RECEIVED**

JAN 23 2009

WATER RESOURCES DEPT  
SALEM, OREGON

Remarks scale - 8" = 1 mile - 660' -