


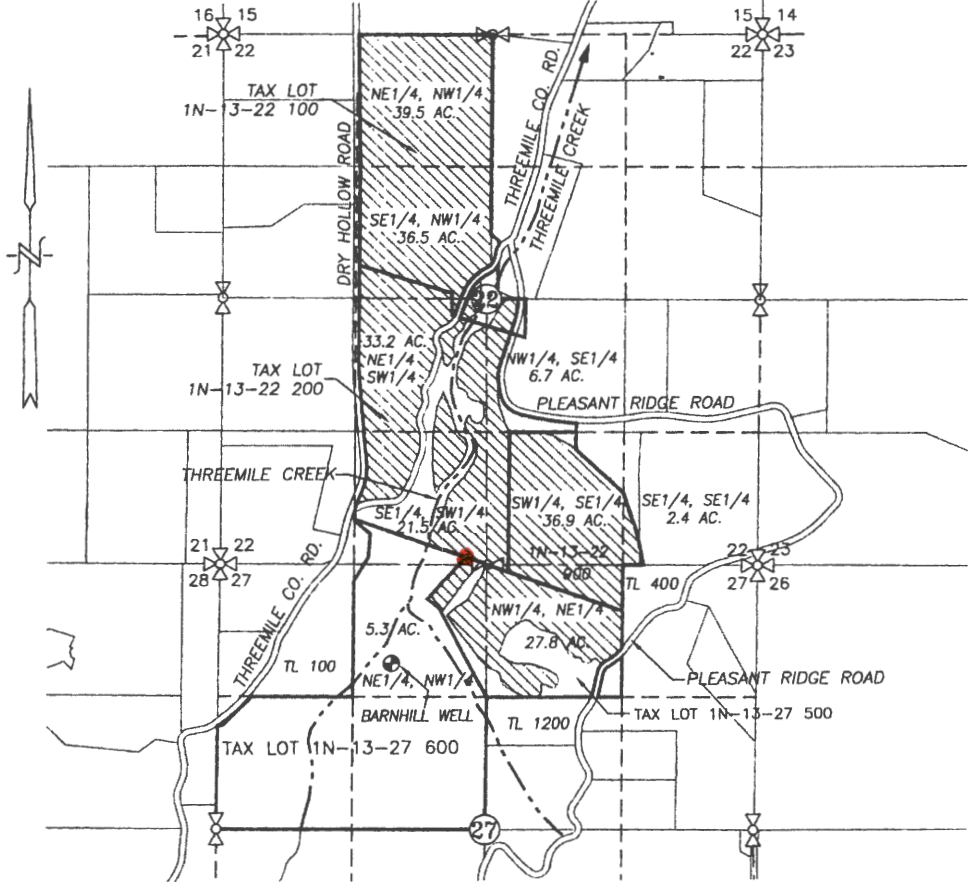

SECTIONS 22 & 27, TWP.1 N. RANGE 13 E. W.M.  
WASCO COUNTY, OREGON




proposed well  
45.54780  
-121.17945  
1N13E Sec 22  
SE SW

EXISTING  
BARNHILL Well  
45.54329  
-121.18049  
1N13E Sec 27  
NE NW


**LEGEND :**

- ⊕ BARNHILL WELL & METER (WASC 51246): 990' S. & 925' W. OF N1/4 COR. SEC. 27
-  SUPPLEMENTAL APPLICATION AREA = 209.8 ACRES RECEIVED BY OWNER
- 4" IRRIGATION MAIN
-  CREEK WITH DIRECTIONAL FLOW

**WATER RIGHT**  
**GROUNDWATER APPLICATION MAP**

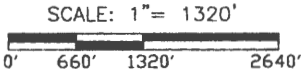


APPLICATION No. \_\_\_\_\_  
 PERMIT No. \_\_\_\_\_  
 IN THE NAME OF:  
 JOHN CARTER  
 DATE: FEBRUARY 13, 2014

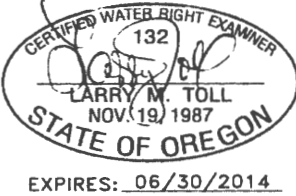

BY: **TENNESON ENGINEERING CORP.**  
 3775 CRATES WAY  
 THE DALLES, OREGON. 97058  
 PH. 541-296-9177  
 FAX 541-296-6657

**NOTE:**  
 "THIS MAP IS NOT INTENDED TO  
 PROVIDE DIMENSIONS OR LOCATIONS  
 OF PROPERTY OWNERSHIP LINES."

G-17770 W.O. #13699wr

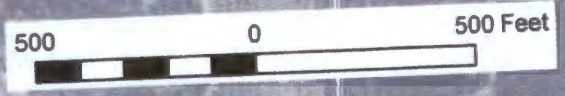

Proposed well  
 lat: 45.54780  
 lon: -121.17945  
 datum: NAD83 HARN

Existing well  
 lat: 45.54736  
 lon: -121.18008  
 datum: NAD83 HARN

*BARN Hill Well*  
 45.54529  
 -121.18049

T1N R13E S22 SW 1/4 of SE 1/4

T1N R13E S27 NW 1/4 of NE 1/4

Tax lot 1N R13E S27 500

**Legend**

- POD Cert: 81733
- Taxlots
- Qtr. Qtr. Lines
- Section lines

**WPN** Watershed Professionals Network, LLC

February 3, 2016

CERTIFIED WATER RIGHT EXAMINER  
 83525CWRE  
 NIKLAS CHRISTENSEN  
 JUNE 13, 2013  
 STATE OF OREGON

Source: Esri, DigitalGlobe, GeoEye, Earthstar Geographics, CNES/Airbus DS, USDA, USGS, AeroGRID, IGN, IGP, swisstopo, and the GIS User Community

T 12301

T 12346

500 0 500 Feet



Proposed well  
lat: 45.54780  
lon: -121.17945  
datum: NAD83 HARN

T1N R13E S22 SW 1/4 of SE 1/4






T1N R13E S27 NW 1/4 of NE 1/4

Tax lot 1N R13E S27 500

Existing well  
lat: 45.54736  
lon -121.18008  
datum: NAD83 HARN

*Brown Hill Well  
45.54736  
-121.18008*

**Legend**

-  POD Cert: 81733
-  Taxlots
-  POU Cert: 81733
-  Qtr. Qtr. Lines
-  Section lines

**WPN** Watershed Professionals Network, LLC

February 3, 2016

T 12301

CERTIFIED WATER RIGHT EXAMINER  
83525CWR/E  
*Niklas Christensen*  
NIKLAS CHRISTENSEN  
JUNE 13, 2013  
STATE OF OREGON

Source: Esri, DigitalGlobe, GeoEye, Earthstar Geographics, CNES/Airbus DS, USDA, USGS, AeroGRID, IGN, IGP, swisstopo, and the GIS User Community