


T. 17S. R. 20E. W.M.

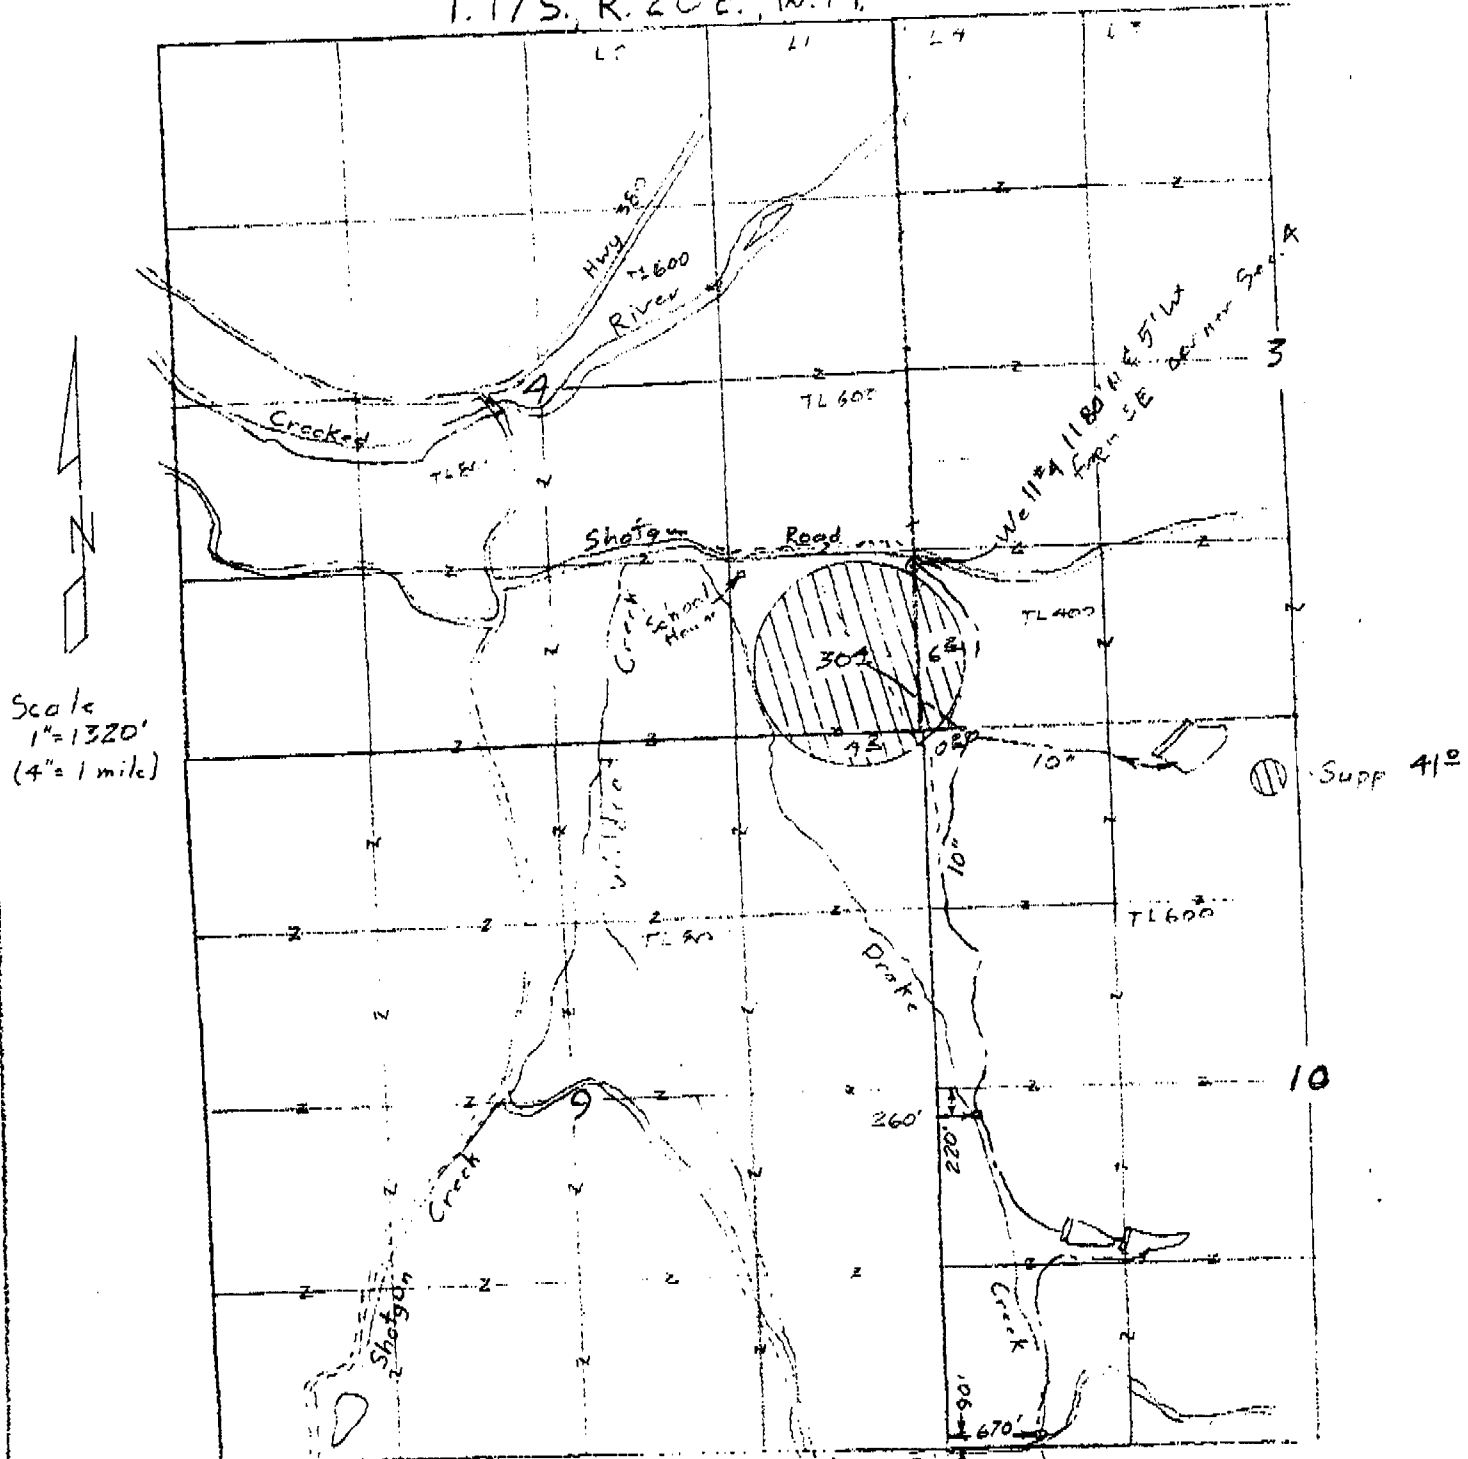


Application Map
for

Shotgun Ranch, LLC

App G-18112

This map is for the purpose of locating a water right only and has no intent to provide legal dimensions or the location of property lines.

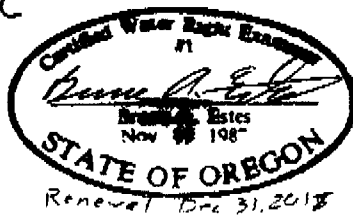

ESTES SURVEYS, LLC
 PO Box 17848 60382 Arnold Rd
 Salem, OR 97388-7918 Bend, OR 97702
 (503) 685-7588 (541) 382-7391

amended Jan 25, 2016

G-18112

01/25/2016