


T40 S R8W Southeast Quarter Section 4

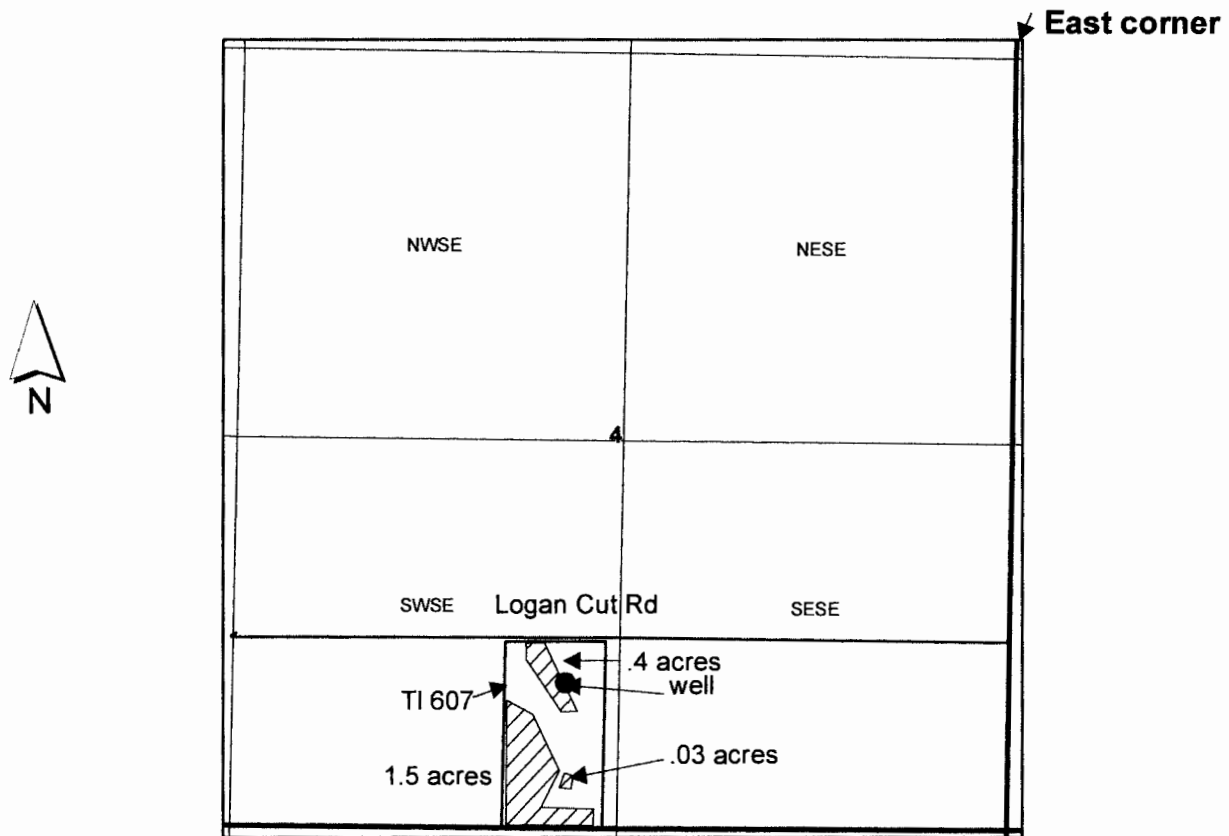

1 inch = 660 feet

The well is located approximately 2154 ft south and 1501 ft west from the east corner of section 4, according to the landowner.

RECEIVED BY OWRD

JAN 28 2016

SALEM, OR

G-18246