


T39S R5W Northwest Section 9

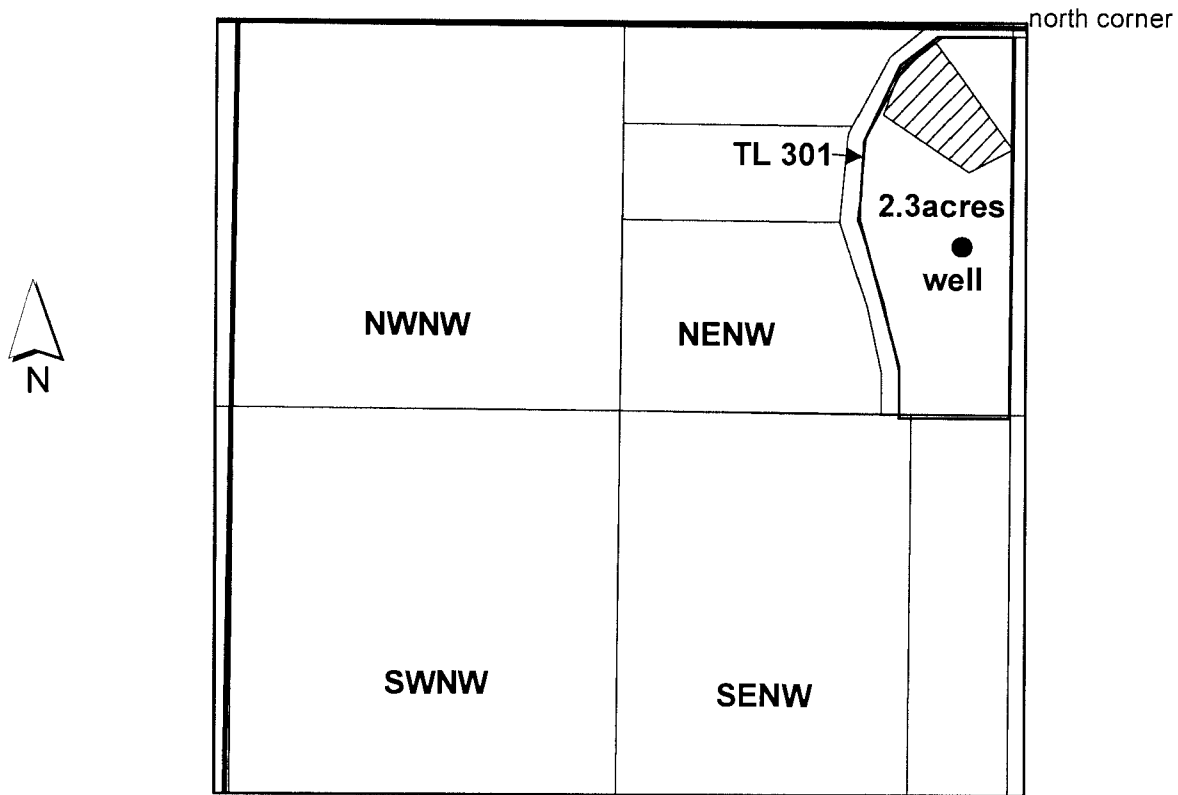

1 inch = 660 feet

The well is located 750 feet south and 178 ft west from the north corner of Section 9.

05/26/2016

G-18107