


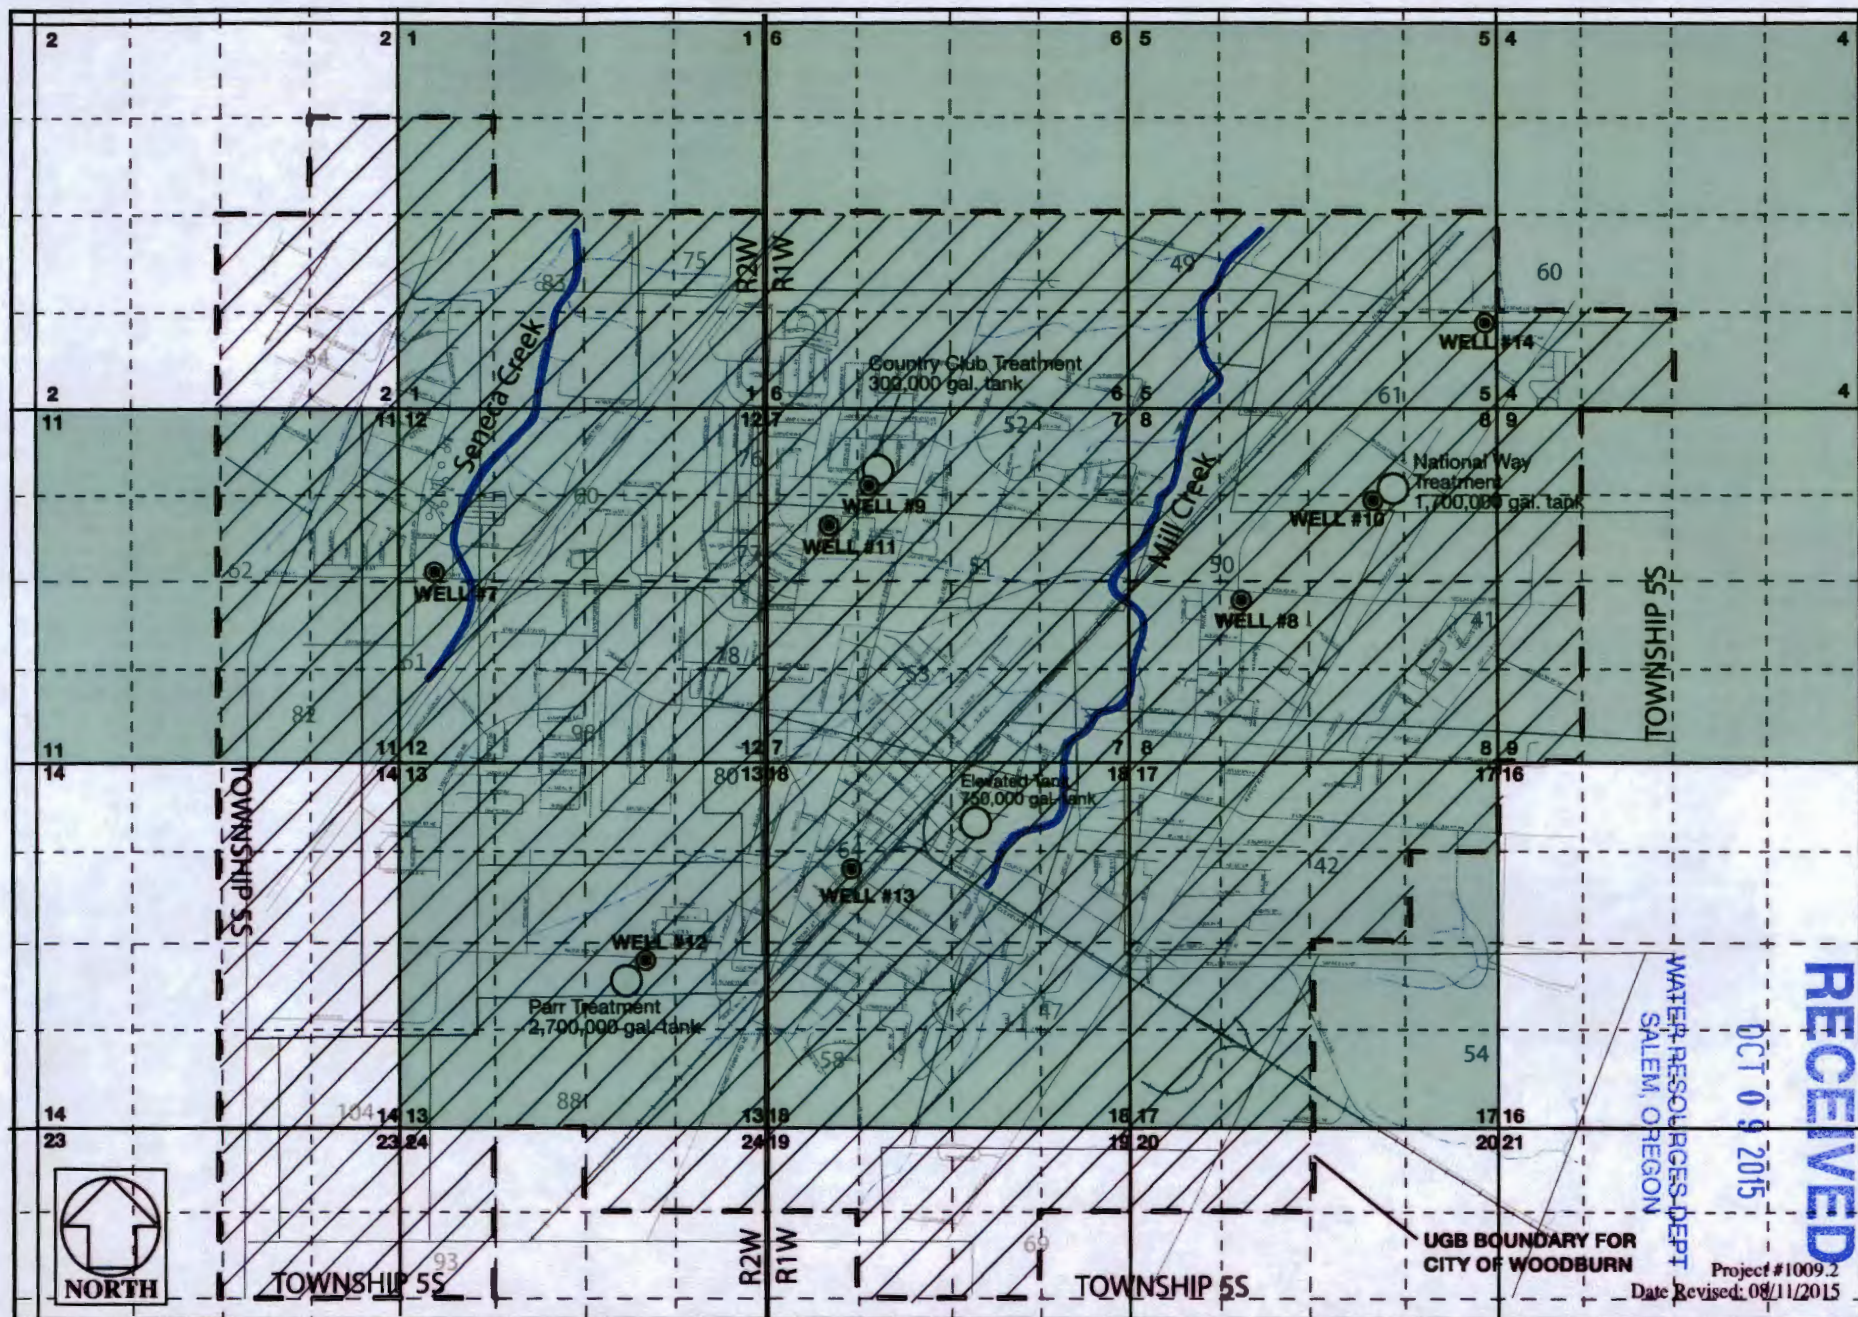

ROGER N. SMITH ASSOCIATES, INC.
Groundwater and Environmental Consultants

LEGEND

- POU Boundary (City UGB)
- Storage Tanks
- Groundwater Registered City Wells (POA)
- Permitted or Certified City Wells (POA)
- Original POU for Well 7, 9 & 11
- DLC Boundary
- ▨ New POU for Municipality (City UGB)

Scale: 1" = 2,640'

PERMIT AMENDMENT MAP FOR WELLS

#7, 9 & 11 12181

RECEIVED
 OCT 09 2015
 WATER RESOURCES DEPT
 SALEM, OREGON
 Project #1009.2
 Date Revised: 08/11/2015

UGB BOUNDARY FOR
CITY OF WOODBURN