


**T36S R6W South half Northwest and
North half Southwest Section 32**

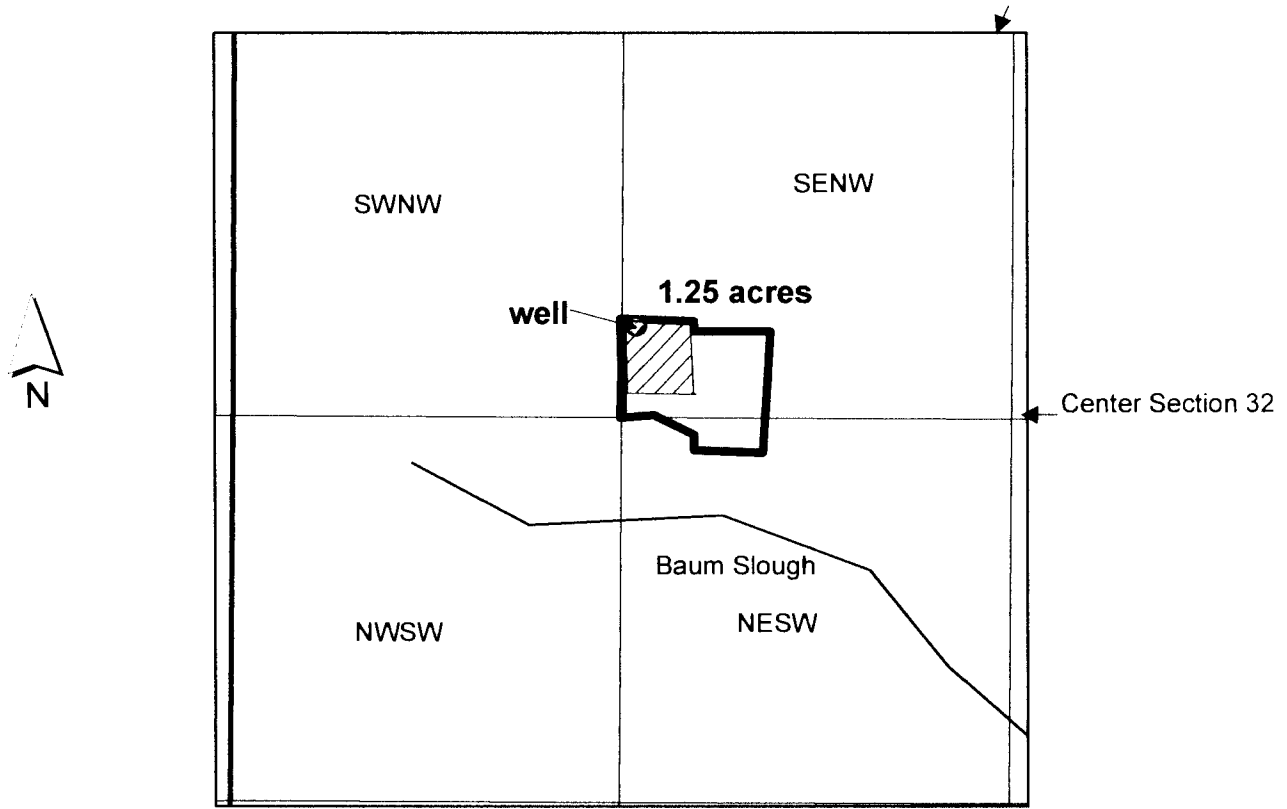

1 inch = 660 feet

The well is located 1263 ft west and 310 ft north from the center of Section 32.

RECEIVED BY OWRD

JAN 04 2016

SALEM, OR

G-19180