


T38S R5W NE Quarter Section 33

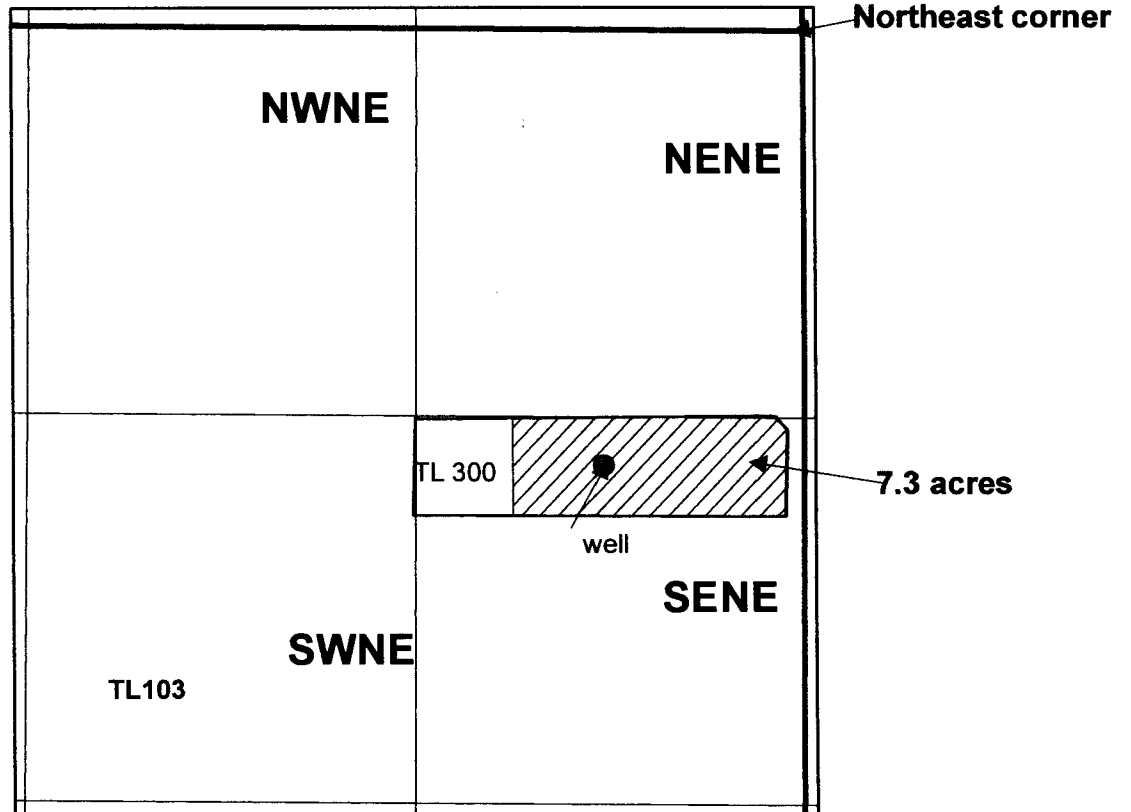

1 inch = 660 feet

The well is 1501 ft south and 694 ft west from the northeast corner.

RECEIVED BY OWRD

FEB 10 2016

SALEM, OR

G-18265