


T35S R7W Northeast Quarter Section 35

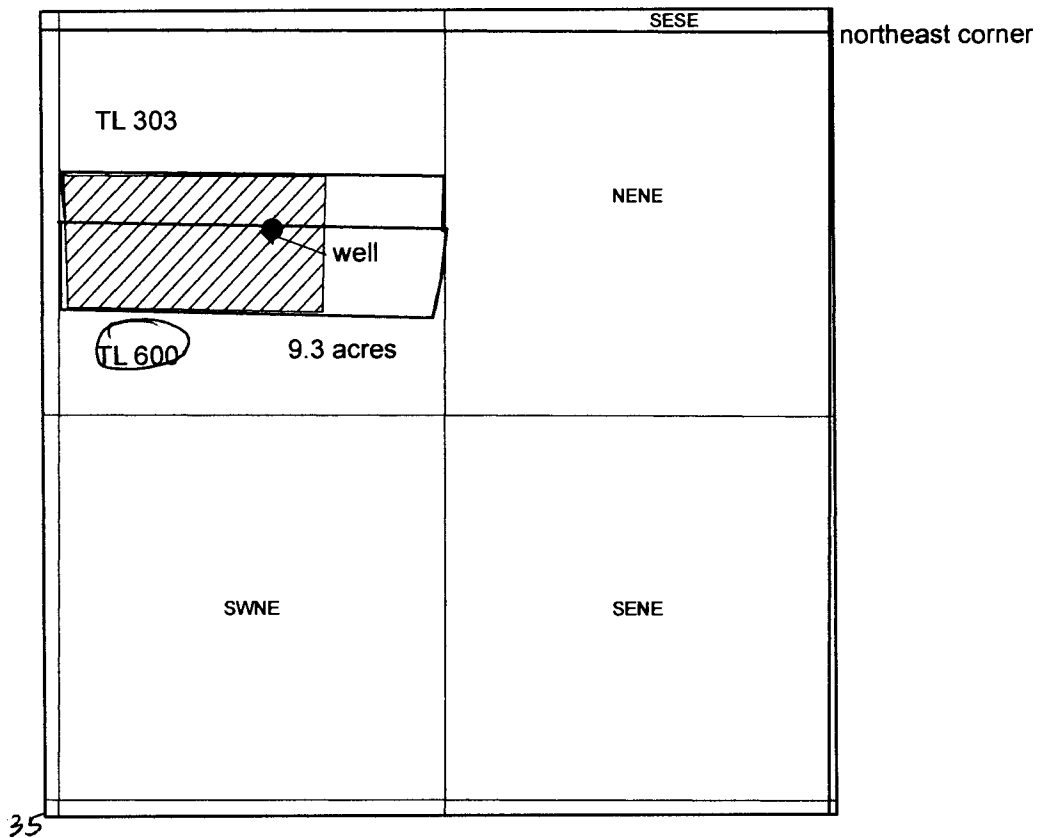

1 inch = 660 feet

The well is approximately 684 ft south and 1912 ft west of the northeast corner of Section 35, according to the landowner.

RECEIVED BY OWRD

AUG 09 2016

SALEM, OR

G-18364