


# T40S R8W Northeast Quarter Section 10

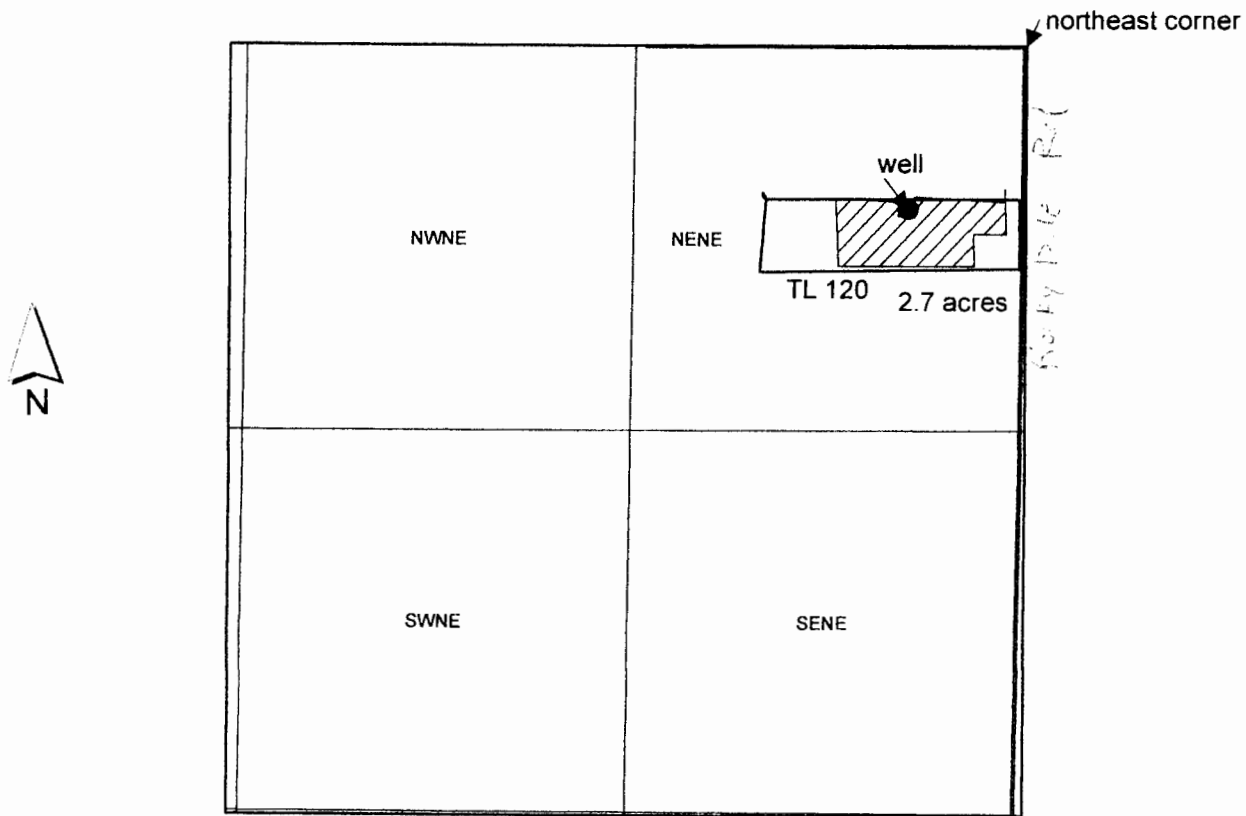

1 inch = 660 feet

The well is approximately 390 ft west and 557 feet south from the northeast corner, Section 10, according to the landowner.

RECEIVED BY OWRD

MAR 08 2016

SALEM, OR

6-10-210