


TAX MAP AND LOT 17 03 24 32 00201  
TL 201

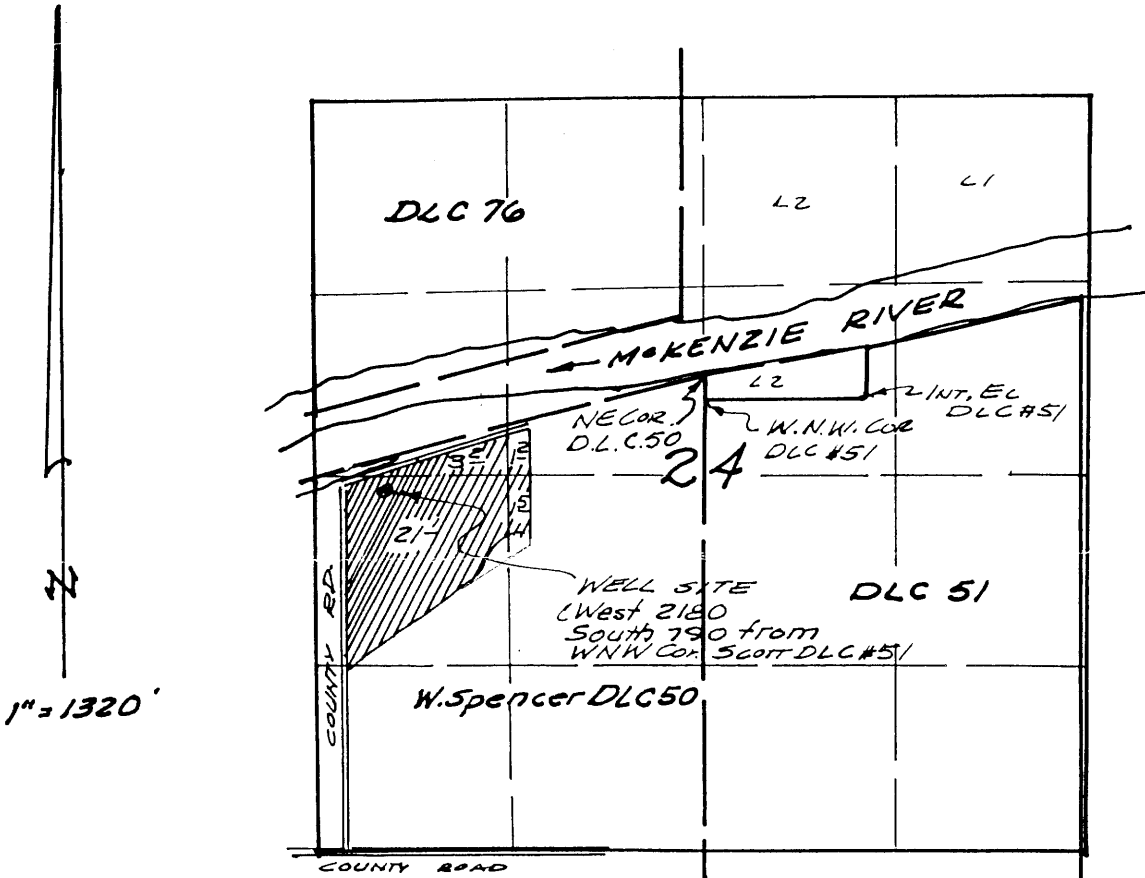

SEC. 24 - T17S - R3W - W.M.

RECEIVED BY OWRC

JAN 09 2015

SALEM, OR

C-17981