


T39S R5W Northwest Section 3

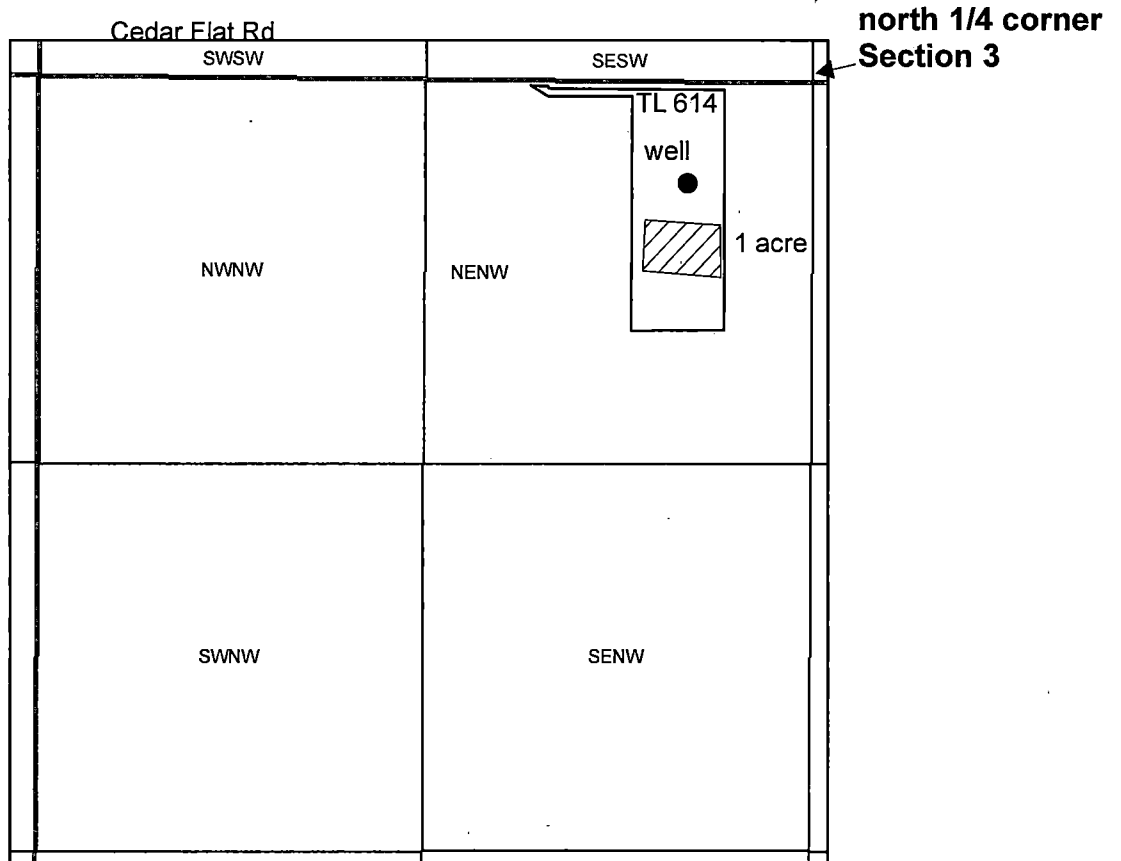

1 inch = 660 feet

The well is approximately 346 ft west and 420 ft south from the north 1/4 corner Section 3, according to the landowner.