


T. 16S., R. 24E., W.M.

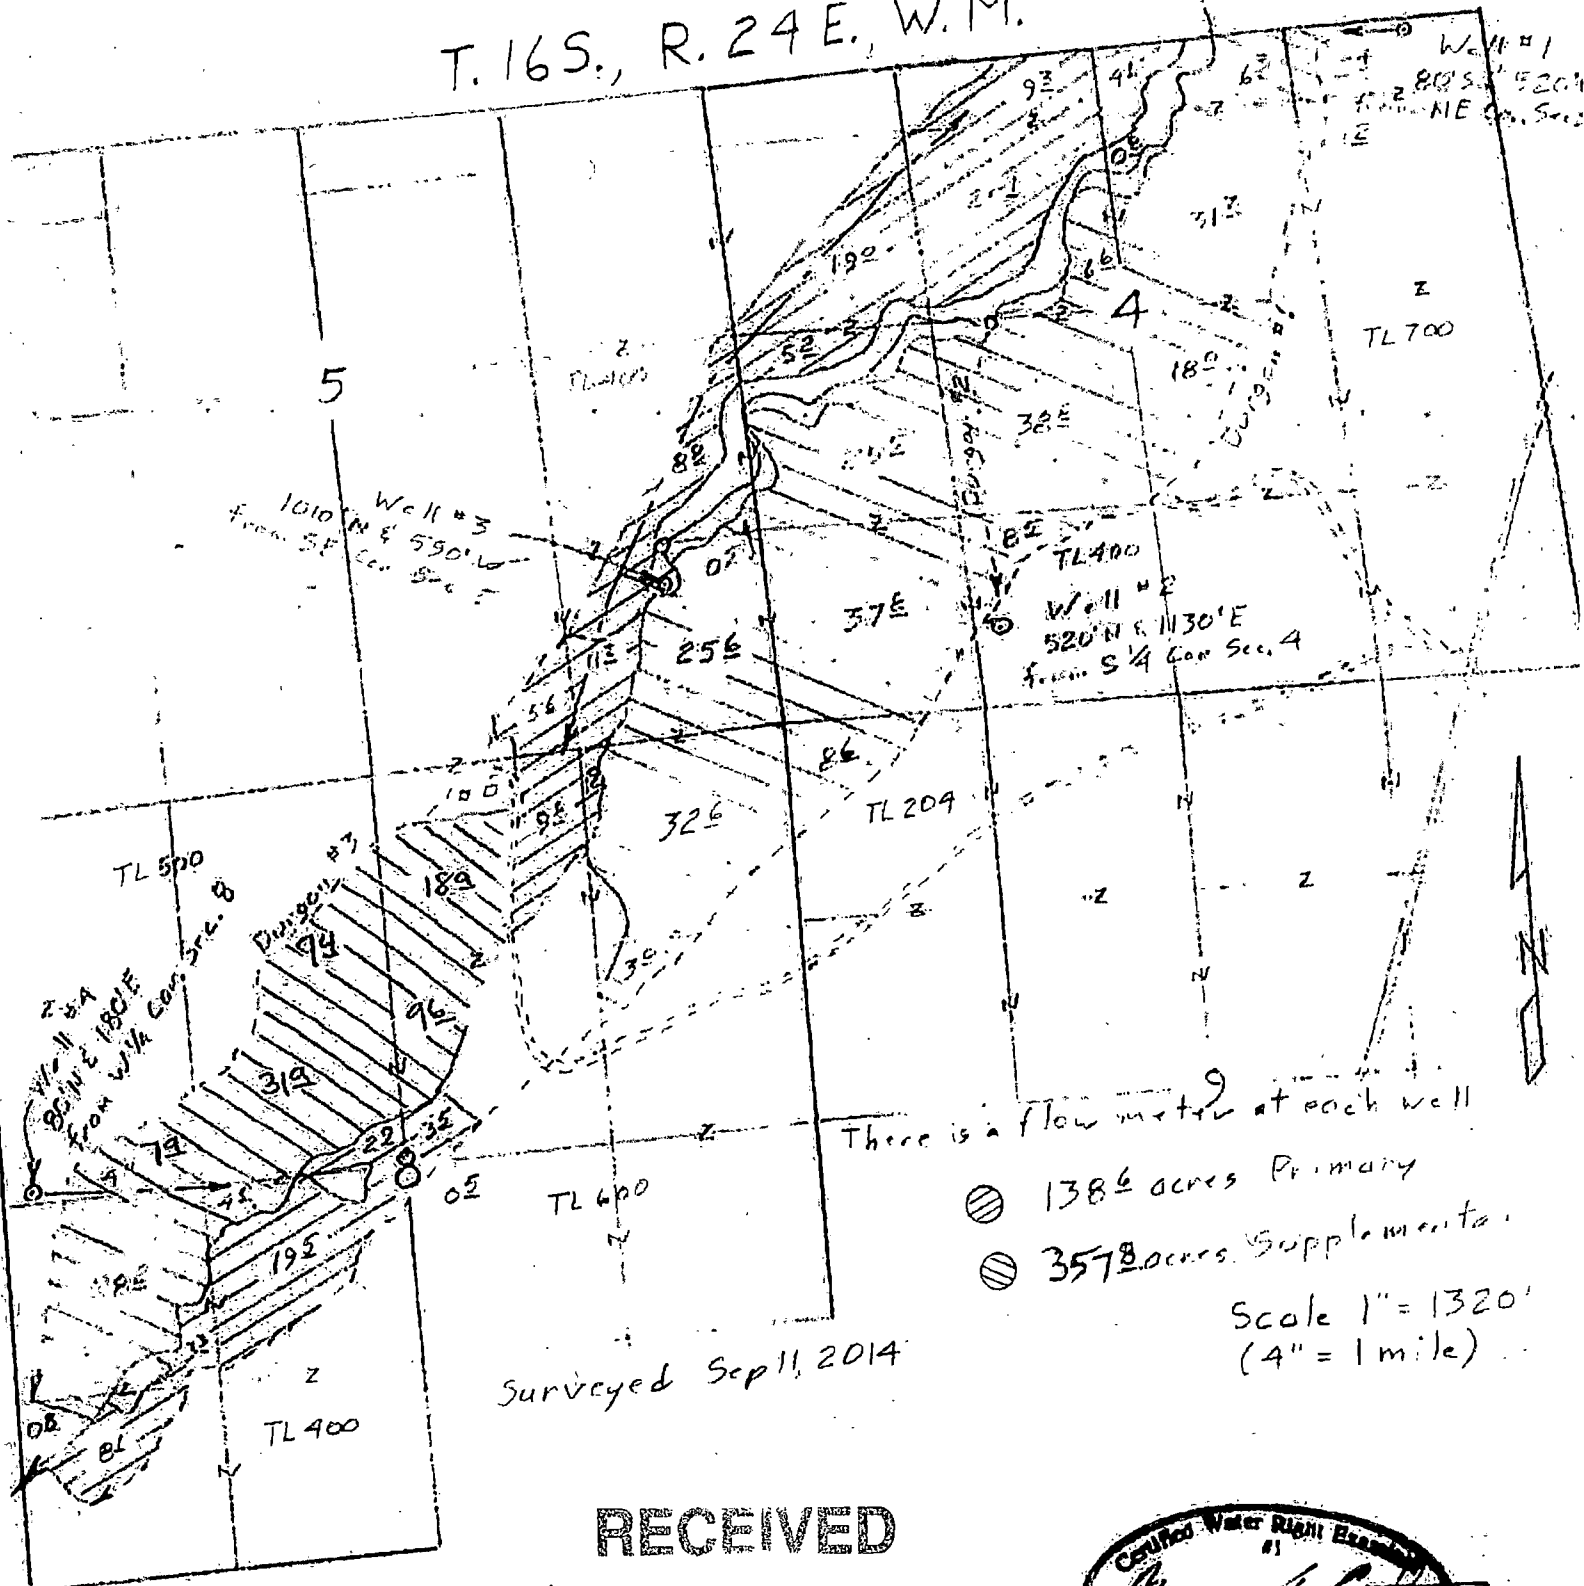

There is a flow meter at each well

- ⊗ 138± acres Primary
- ⊗ 357± acres Supplemental


Scale 1" = 1320'
(4" = 1 mile)

Surveyed Sep 11, 2014

RECEIVED

MAY 27 2015

WATER RESOURCES DEPT
SALEM, OREGON

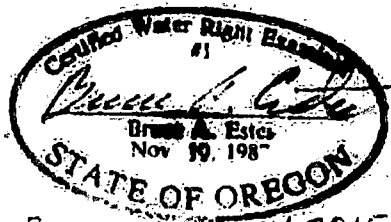

Renewal Dec 31, 2015

This map is for the purpose of
locating a water right only
and has no intent to provide
legal dimensions or the location
of property lines.

ESTES SURVEYS, LLC

PO Box 17519
Salem, OR 97305-7519
(503) 586-7550
60382 Amold Rd
Bend, OR 97702
(541) 382-7391

G-10005