



TS 39-7W-31 TL 201 NENW

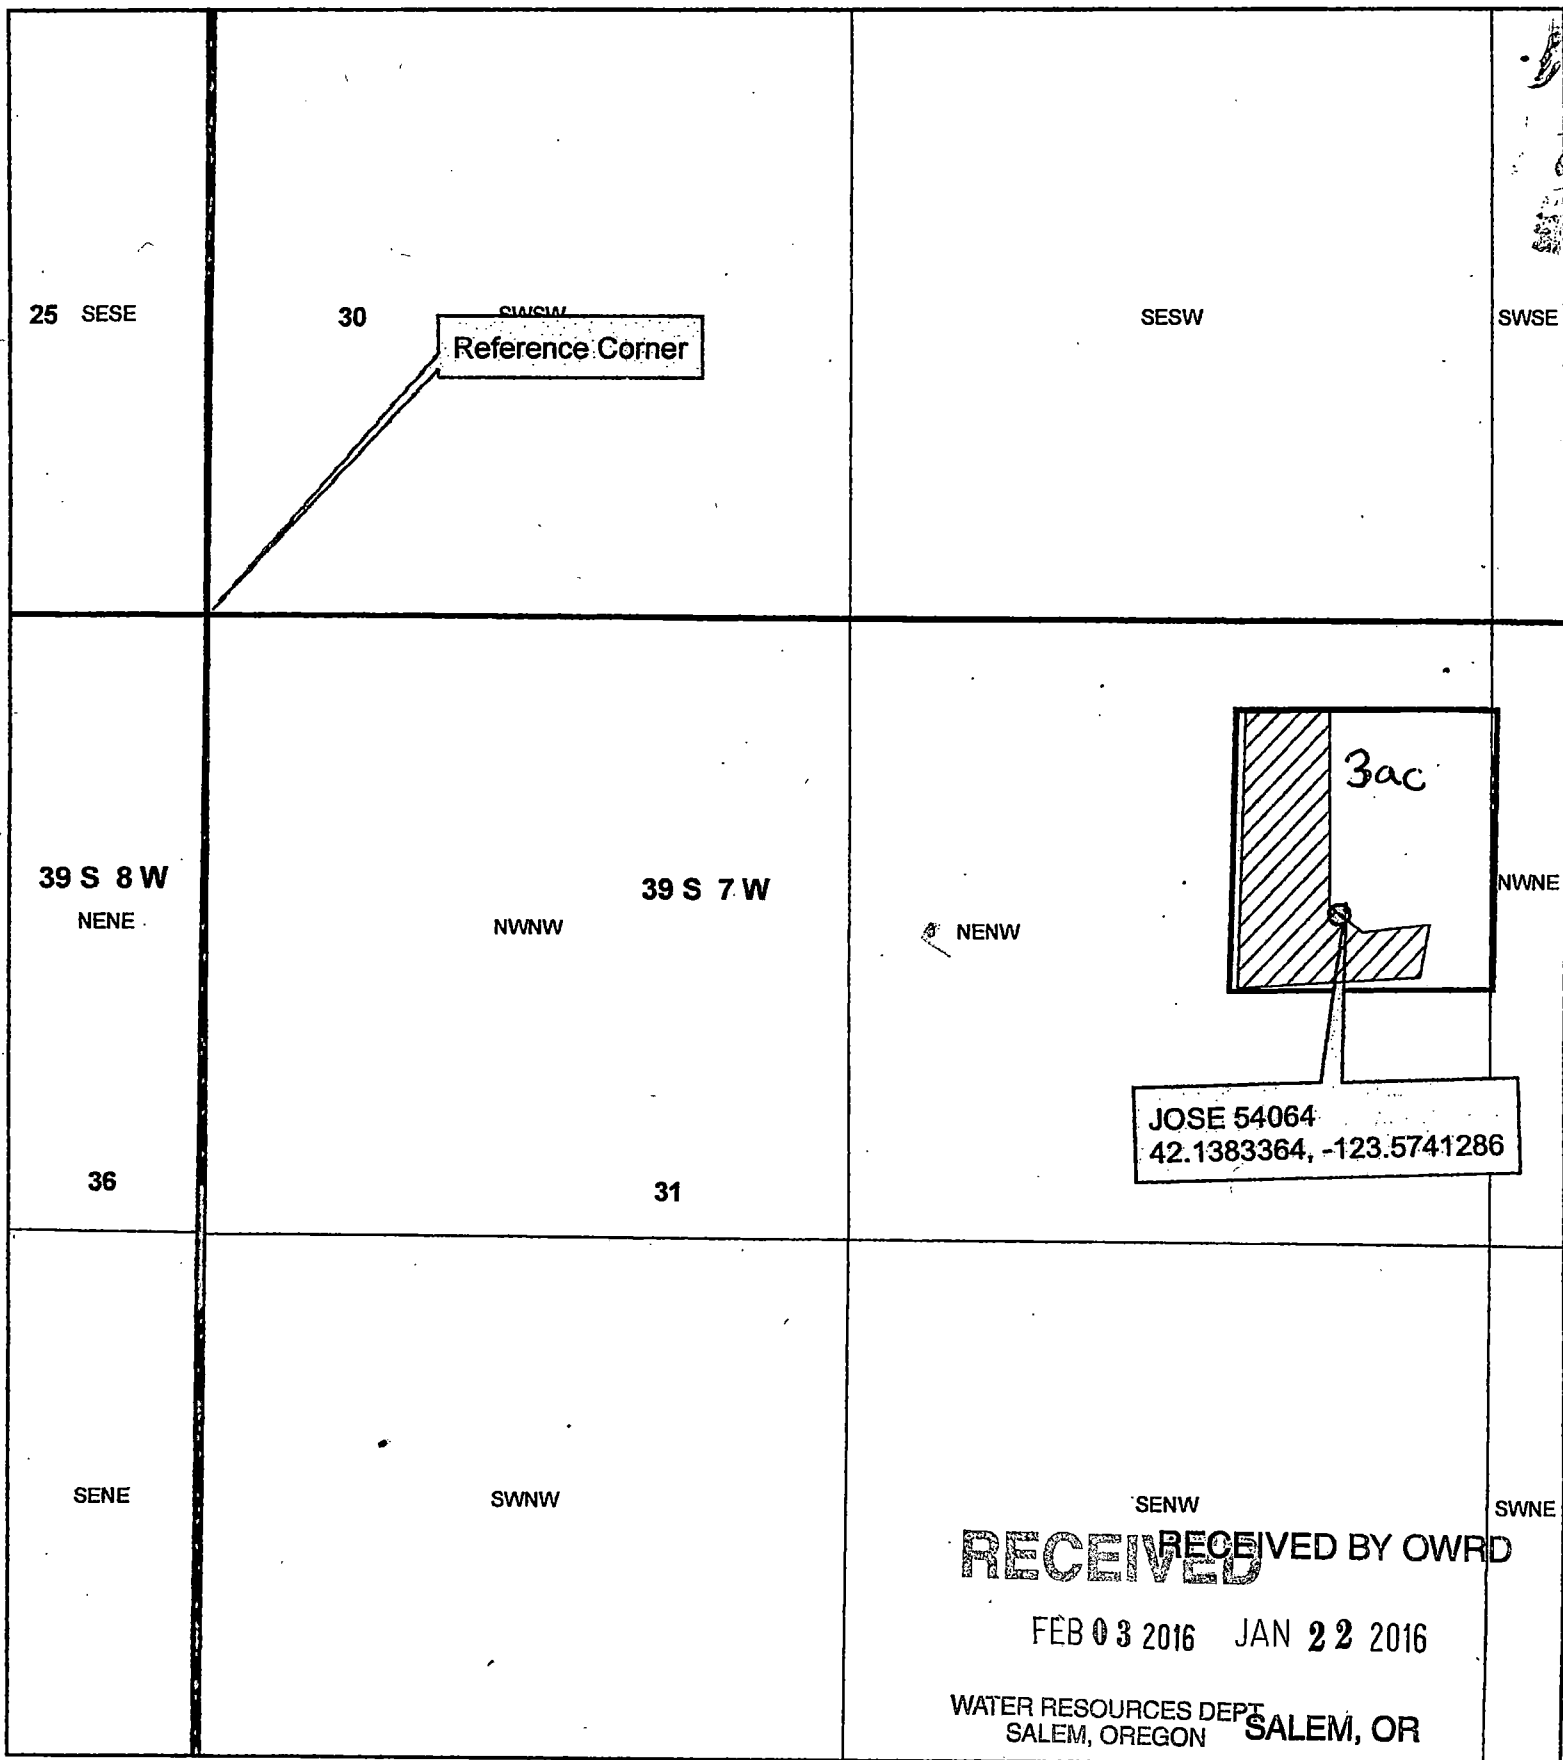

Legend

- TL 201
- Townships
- Sections

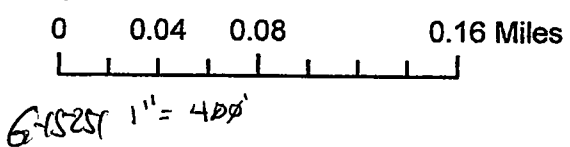

Well (JOSE 54064) is
2363 ft East and
634 ft South of NW Corner
of Section 31

