

PREPARED FOR
USES ONLY

42.26 CH. O.L.D. S53°27'E

1/4 COR.

82.25 CH. O.L.D.

SEE MAP 14 3W 6


SEC. 07 T. 14S. R. 03W. W. 1/4
LINN COUNTY, OREGON

1" = 600'

101
91.32 AC.

100
87.24 AC.

LOT
44.57 AC.

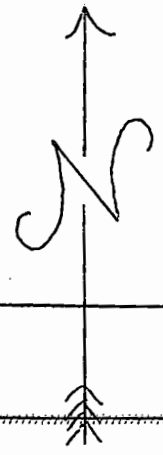

PARTITION

PLAT 35°

LOT
44.72 AC.

2003 - 40 20°

NO.

Well is Proposed
50' S and
50' W of NE
corner Sec 7

PARCEL 2

PARCEL 1

400
237.27 AC.

552-4

LOT
44.87 AC.

LOT
45.02 AC.

RECEIVED BY OWRD

FEB 16 2016

SALEM, OR

40.70 CH. PER DEED (2888-2)

1/4 COR.

C. R. 23 LAKE CREEK DR.

SEE MAP 14 3W 18

401
77.28 AC.

7 8

18 17

RD.