



RECEIVED

JUL 08 2010

# T.4S. R.2W. Sec. 30 & 31 and R.3W. Sec. 25 & 36, W.M.


Proposed Well 2 is located 415 feet south and 1,170 feet east from the NW corner, Section 31.  
Proposed Well 3 is located 350 feet south and 2,780 feet west from the NE corner, Section 36.

 Area (131.7 Acres) to be irrigated.


 Donation Land Claim boundary

 Tax lot boundary

 Irrigation mainlines

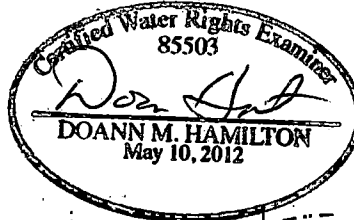

REVISIONS *June 30 2017*

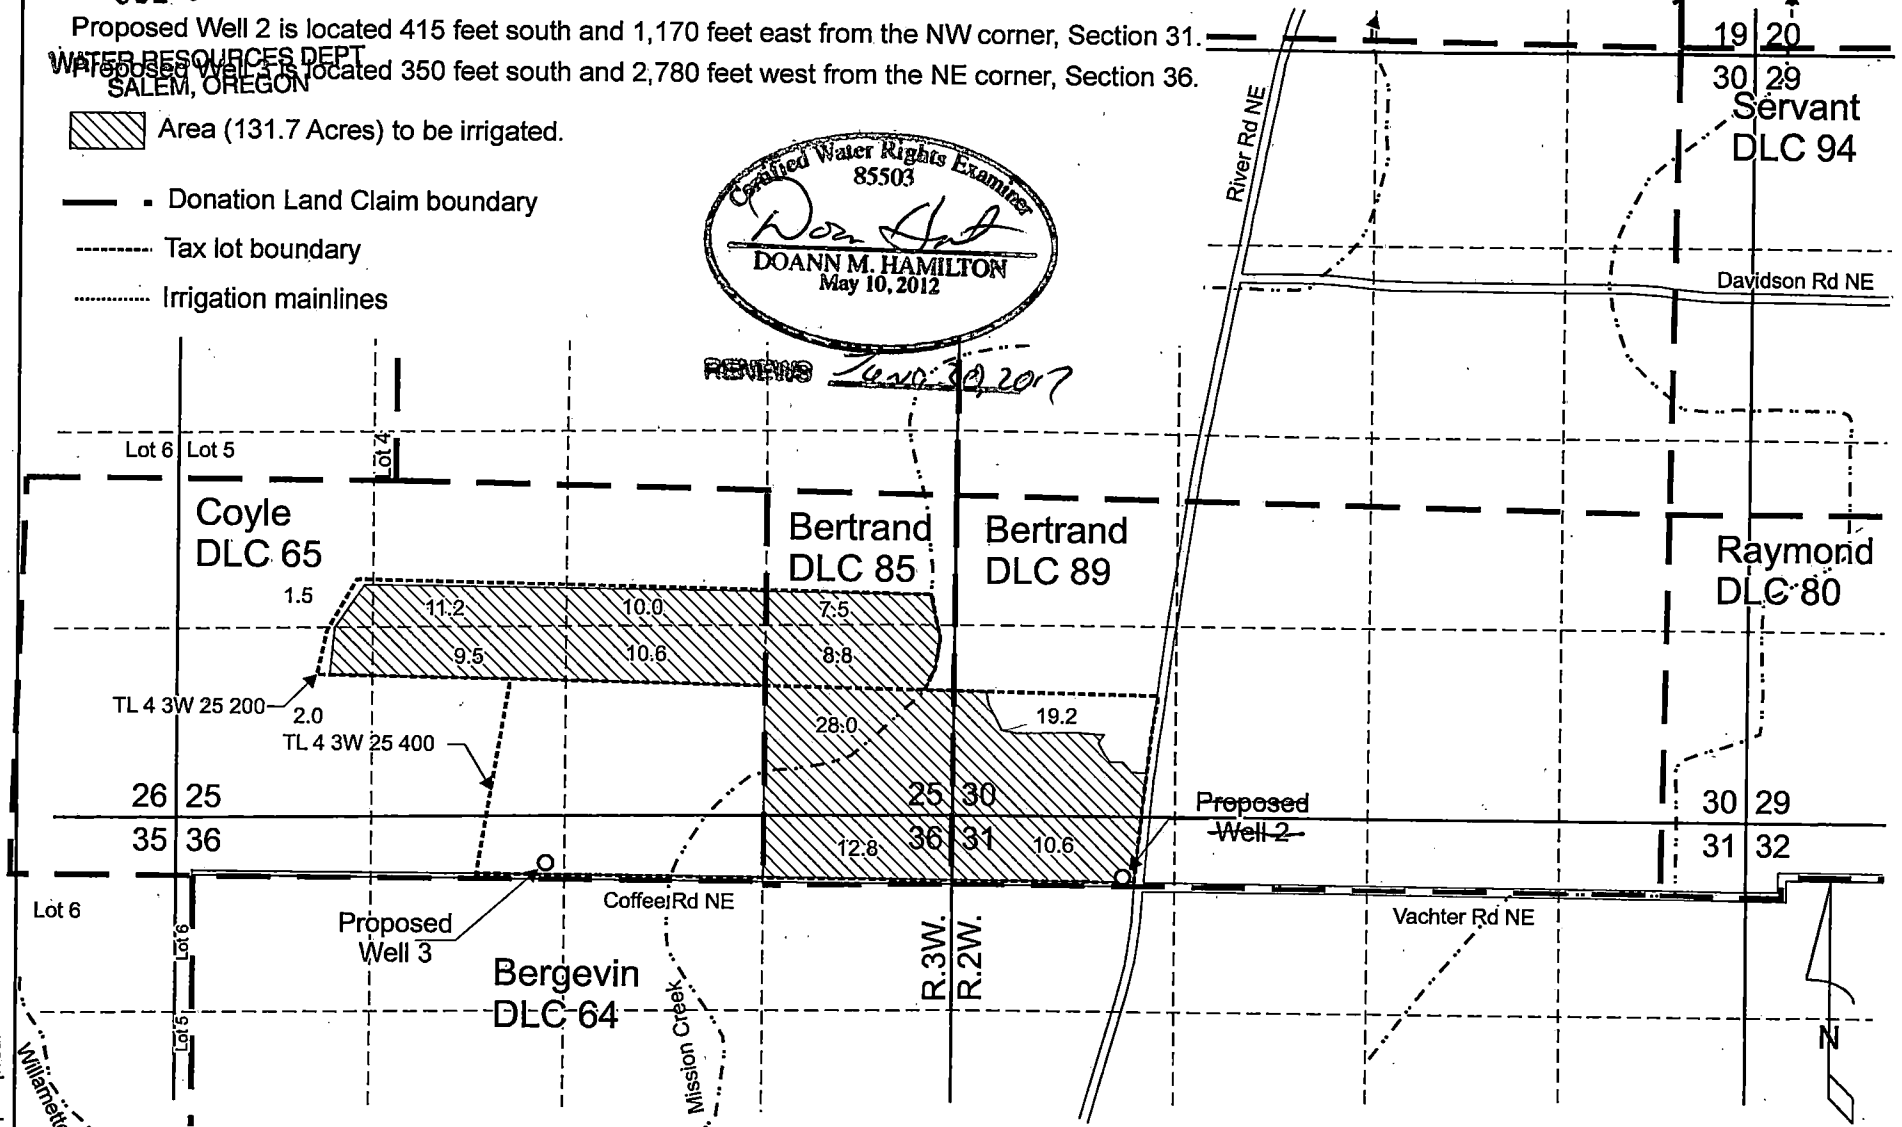

This map was prepared for the purpose of identifying the location of a water right only and is not intended to provide legal dimensions or location of property ownership lines.

Pacific Hydro-Geology Inc.

06/2016

## New Groundwater Application Map

Mike Davidson  
T.4S. R.2W. Sec. 30 & 31 and  
T.4S. R.3W. Sec. 25 & 36, W.M.

DavidsonGWAppMap.cdr

6-10-336