


T37S R5W Southeast Quarter Section 28

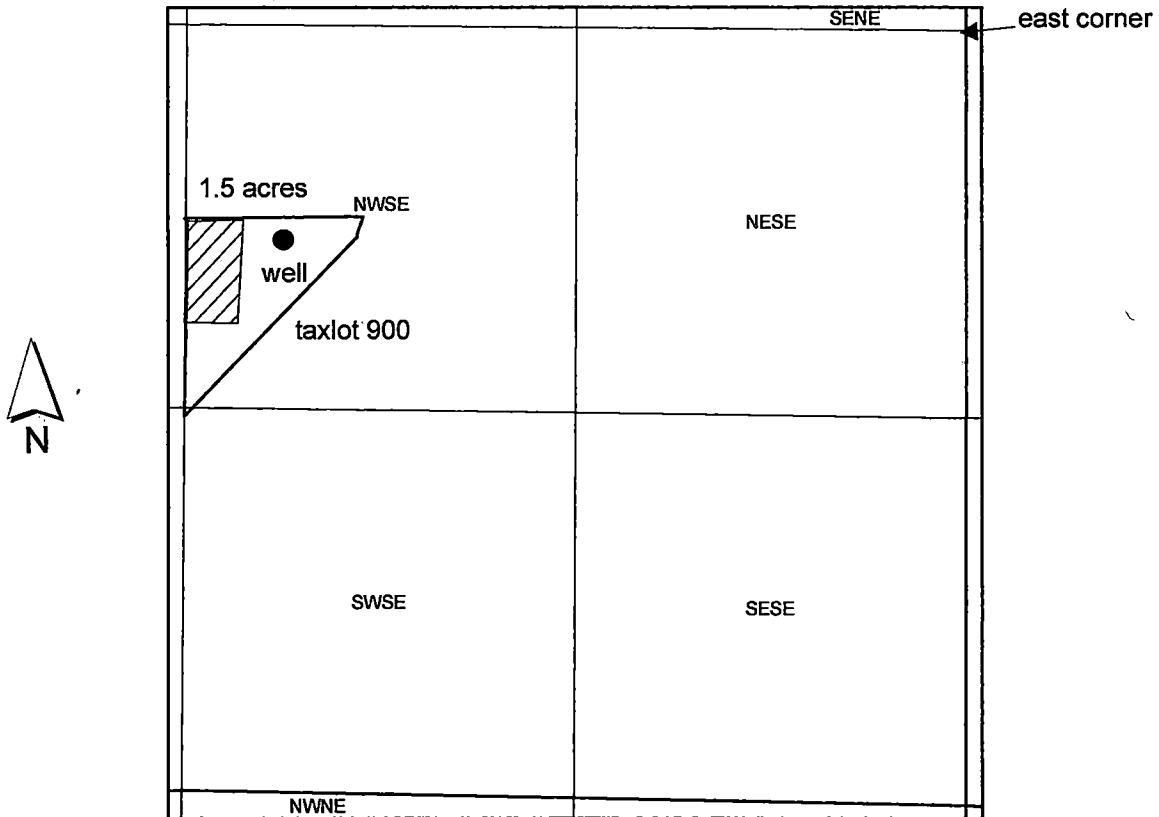

1 inch = 660 feet

The well is approximatel 735 ft south and 2361 ft west from the east corner of Section 28, according to the landowner.

RECEIVED BY OWRD

OCT 17 2016

SALEM, OR