


T38S R5W Southeast Quarter Section 15

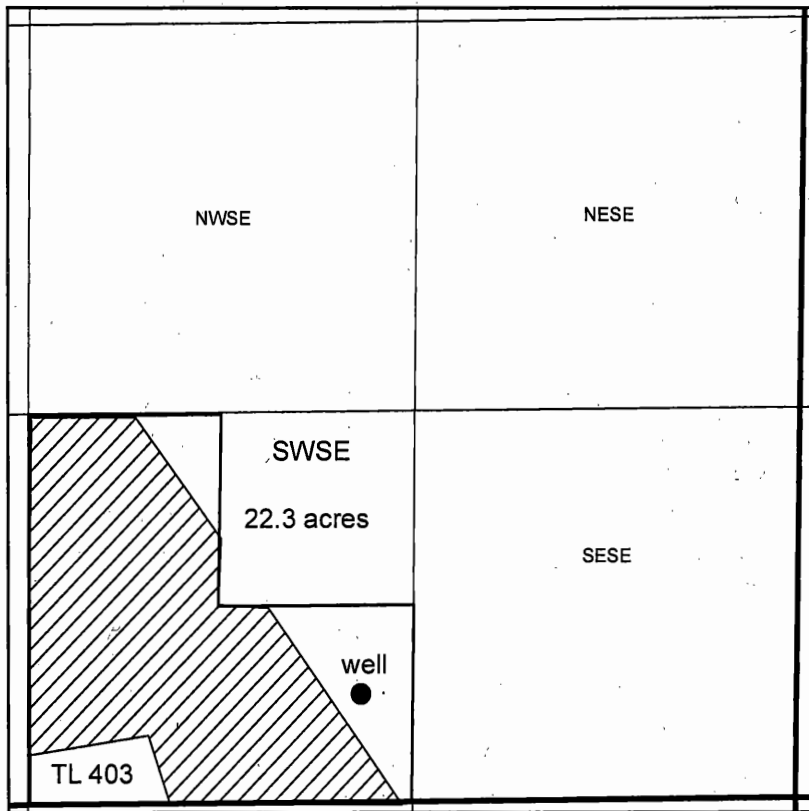

1 inch = 660 feet

The well is located approximately 1491 ft west and 369 ft north from the southeast corner of Section 15, according to the landowner.