


**T35S R7W South Half Northwest Quarter and
North Half Southwest Quarter Section 35**

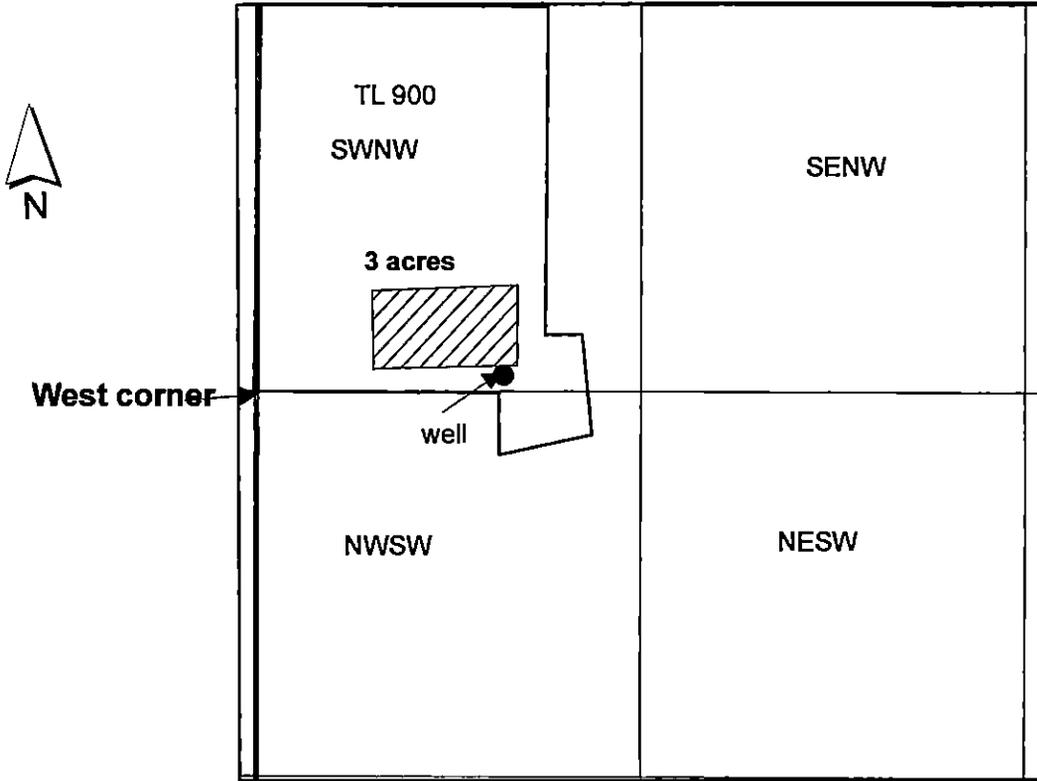

1 inch = 660 feet

**The well is located approximately 53 ft north and
851 ft east from the west corner of Section 35.**

RECEIVED BY OWRD

JAN 25 2016

SALEM, OR

6-18239