
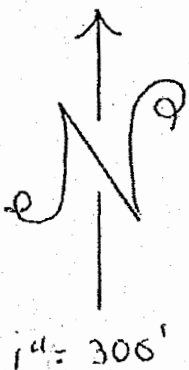


JUN 10 2016

SALEM, OR

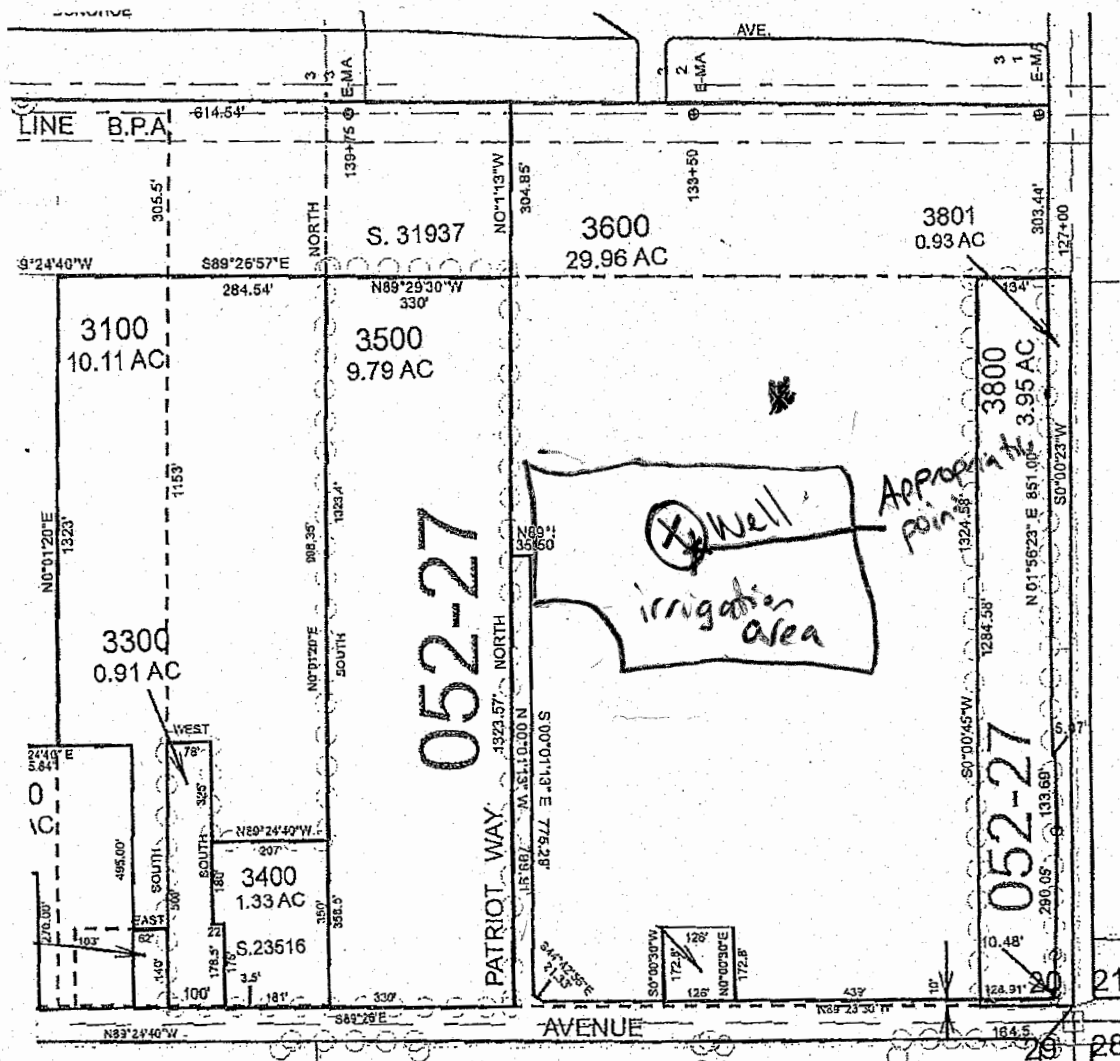

T 17 S, R 4 W Sec 20  
 SE 1/4, SE 1/4

RECEIVED BY OWRD

JUL 05 2016

SALEM, OR

Well is 986 ft North and 455 ft West from  
 SE corner section 20

Bethel FARM WELL