


SECTION PLAT

Section 4, 3, 9, 10, 16, 15 Township 24S Range 27E

County of Harney State of Oregon

NORTH

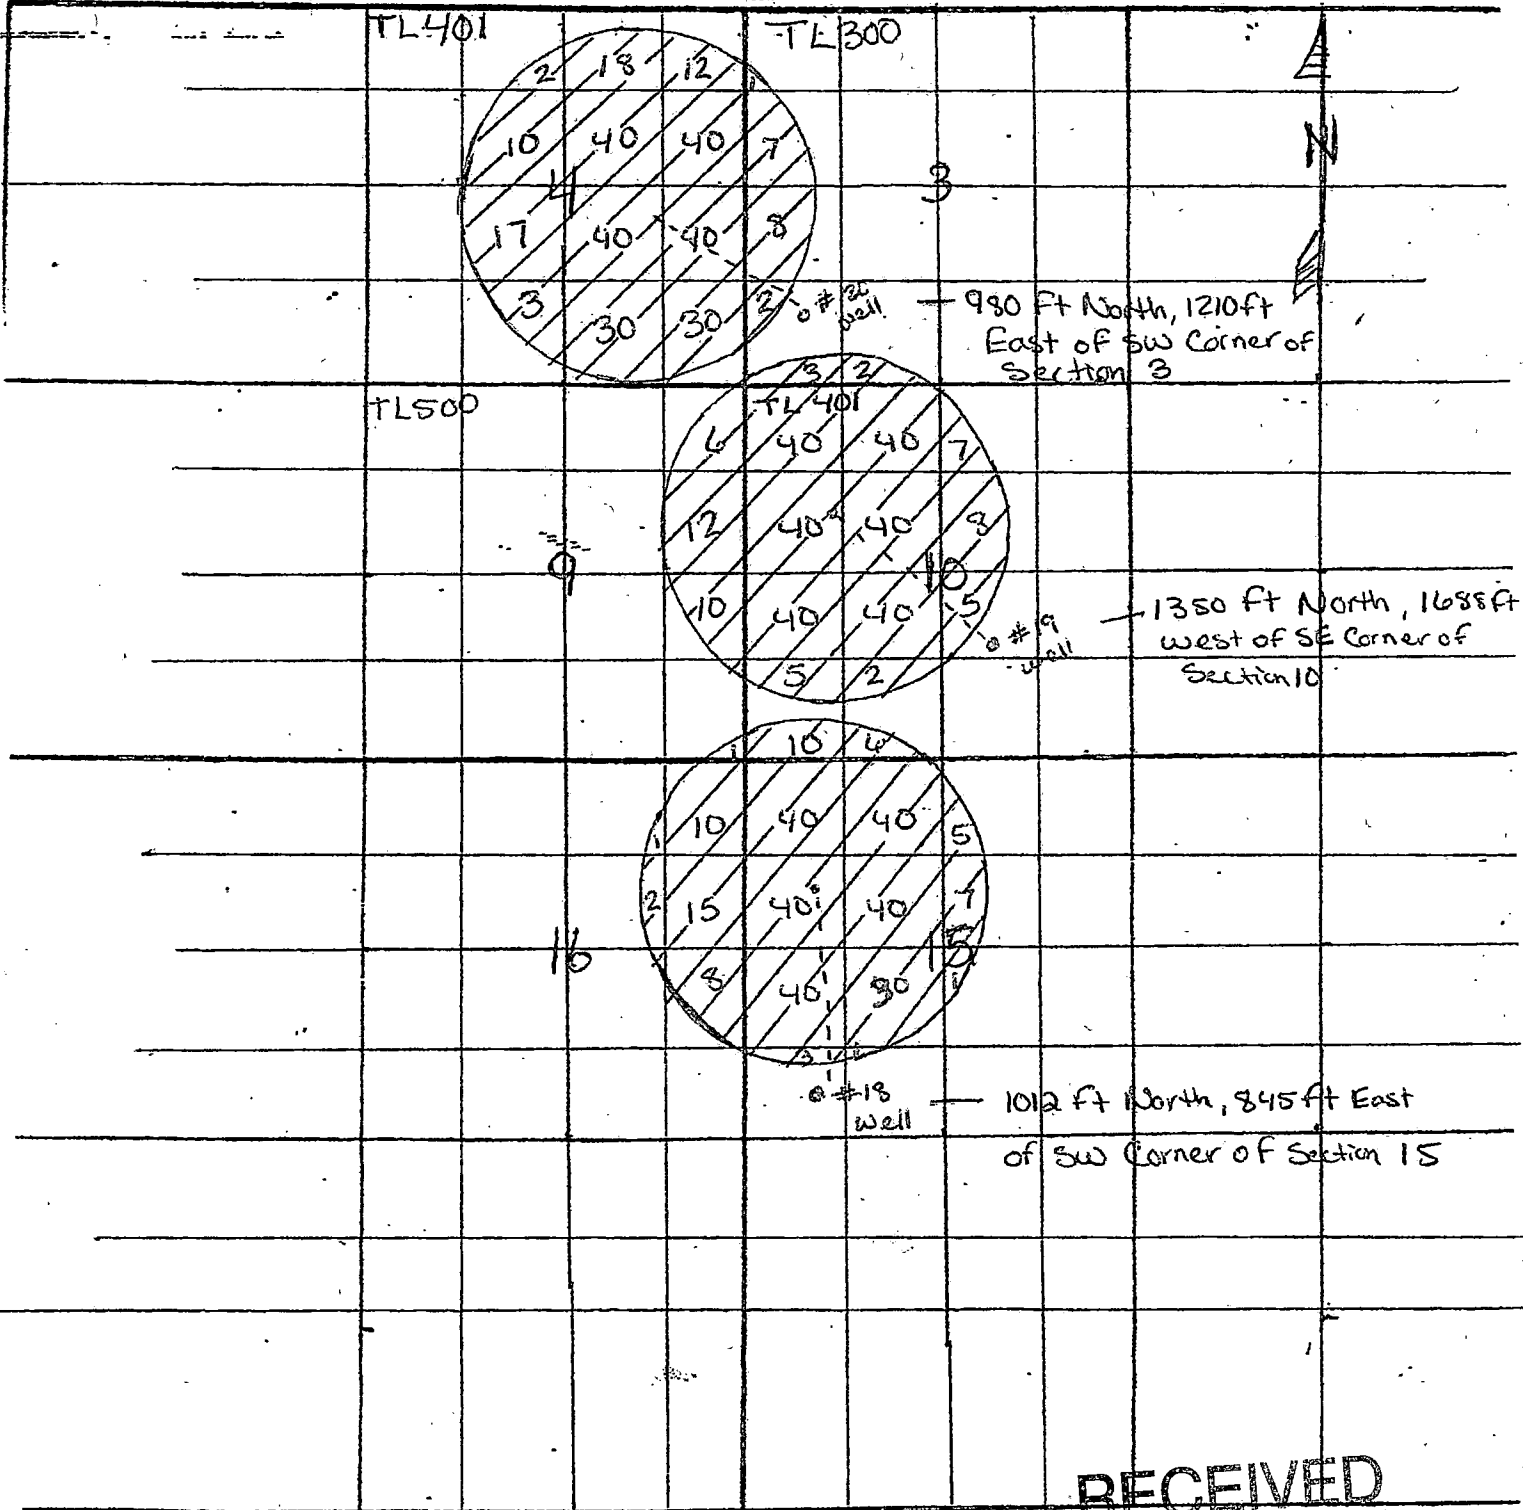

RECEIVED

AUG 14 2017

OWRD

AP # G-17916

Revised MAO