


6/30/2016

<https://mail.google.com/mail/u/0/?tab=wm>

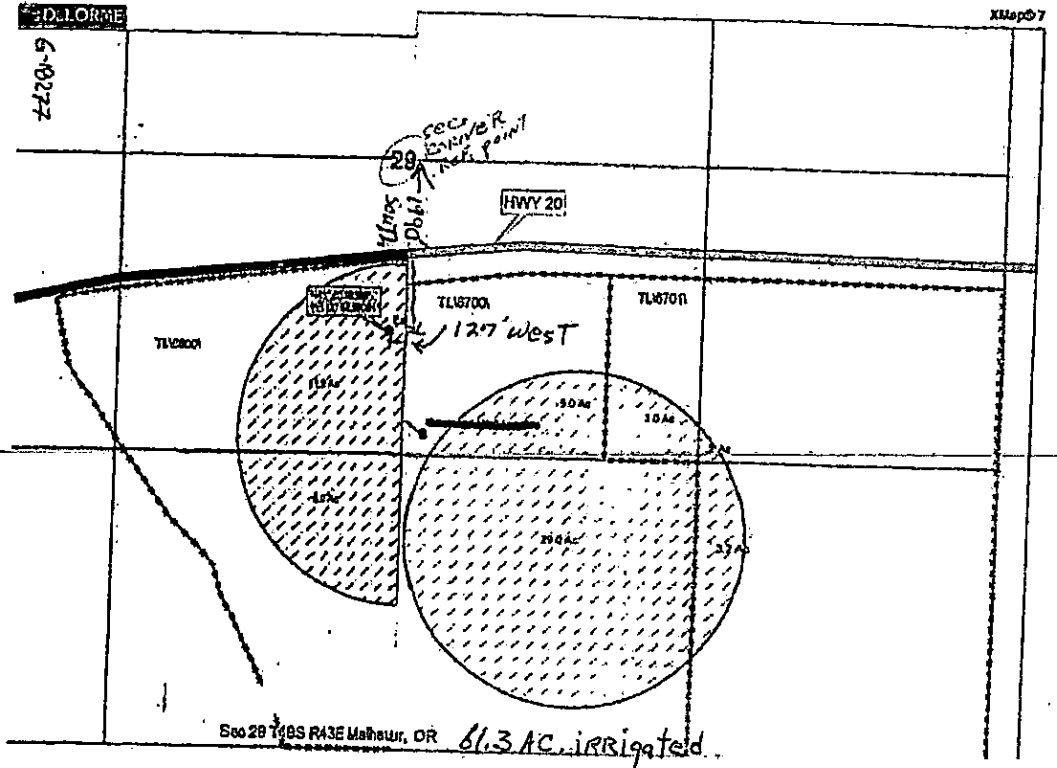

RECEIVED BY OWRD

JUN 31 2016

RECEIVED

JUL 01 2016

WATER RESOURCES DEPT  
SALEM OREGON