


T39S R8W Northwest Quarter Section 34

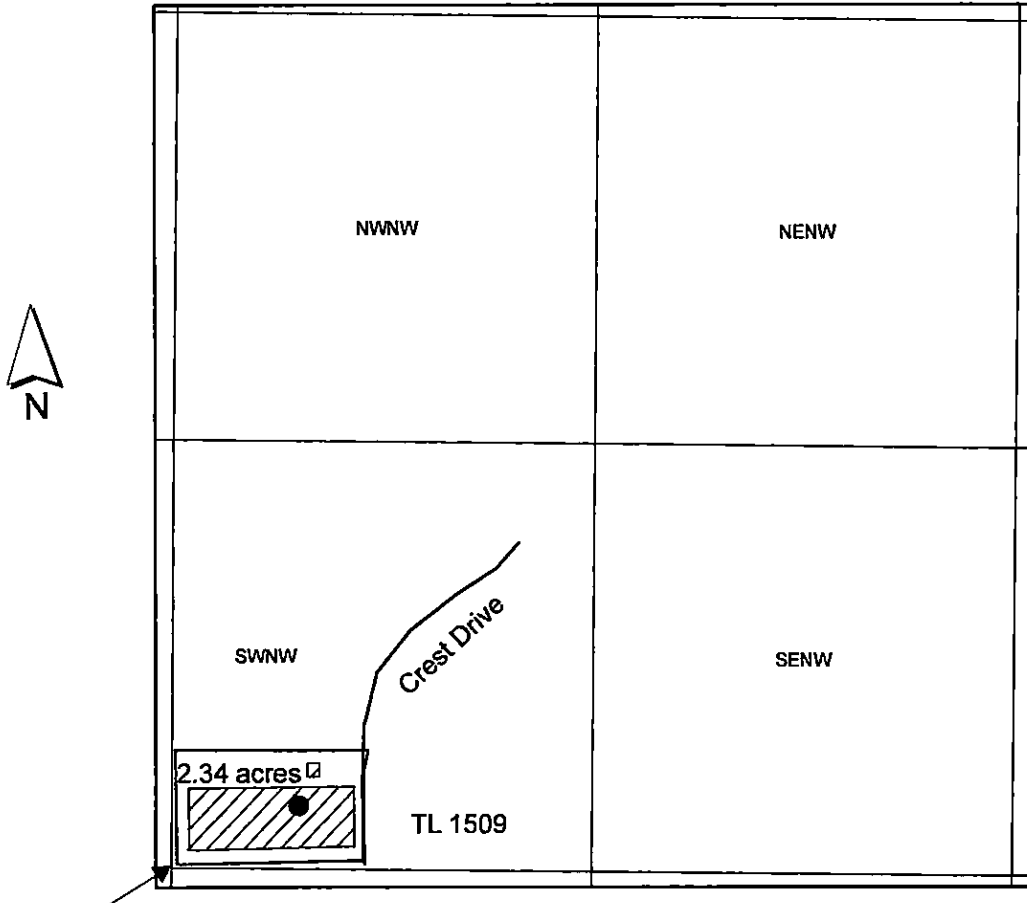

west corner Section 34

1 inch = 600 feet

**The well is located approximately 173 ft north
and 400 ft east from the west corner,
according to the landowner.**

RECEIVED BY OWRD

AUG 26 2015

SALEM, OR

G-18376