


Section 9  
 Township 16S Range 4W WM

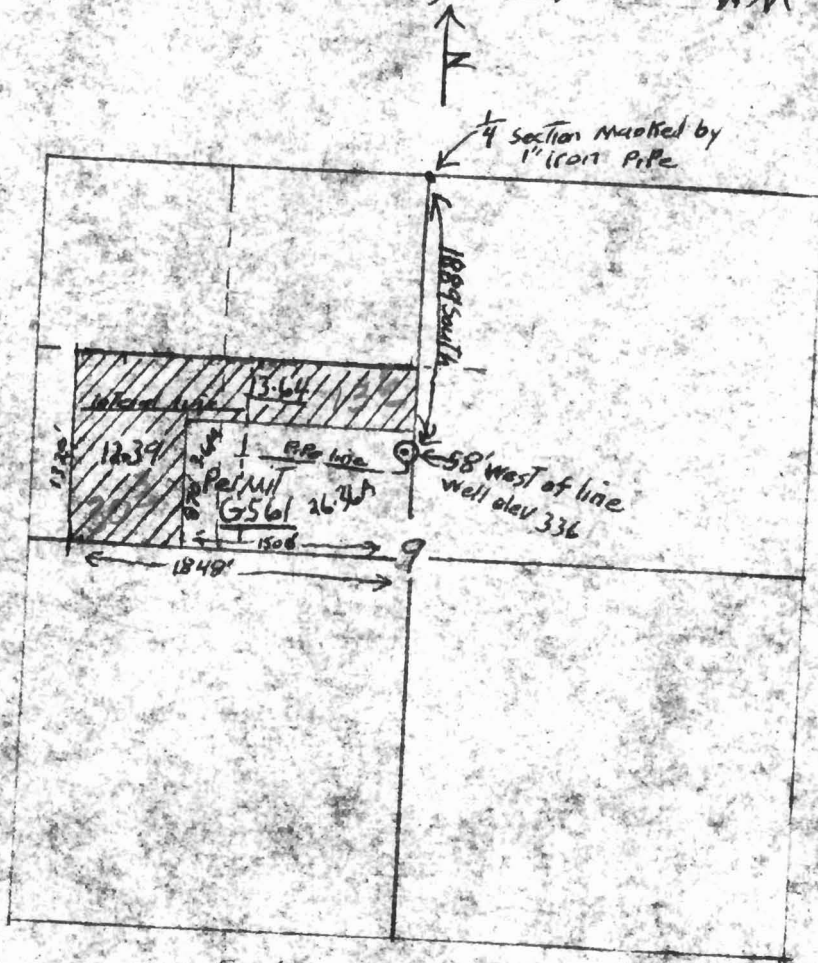

Scale 4" = 1 mile

18.64  
 12.39  
 26.03 A

RECEIVED  
 COUNTY ENGINEER

Application No. G-1953  
 Permit No. G-1797