

Frogson Farm  
 4397 S. Lone Hollow Rd.  
 Woodburn, OR 97071


Township: 01 S *SS*  
 Range: 05 W *1 W*  
 Section: 14  
 Quarter/Quarter: NE SW  
 Taxlot #: 51W14 01101  
 Parcel #: 01082553

- Property Boundary
- Buildings - Existing & Proposed
- Asphalt
- Proposed area for irrigation

RECEIVED

FEB 24 2017

OWRD

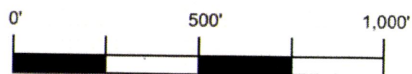

1" = 500'

Property listed as 10.01 acres, irrigation would be used for 7.75 acres as designated above.  
 (P) Well #1 located 280 ft South and 360 ft East of Marker D.L.C. No. 45.

*618966*