G-10281

BOOK 22

SECTION 12 T.40S. R.8W. W. M.
JOSEPHINE COUNTY

40 8 12

This map was prepared for assessment purpose only.

Groundwater Application Map

N

1" = 880'

Drawn by
Gordon R. Lyford
CWRE # 341
3-26-2016
for Tom Meyer

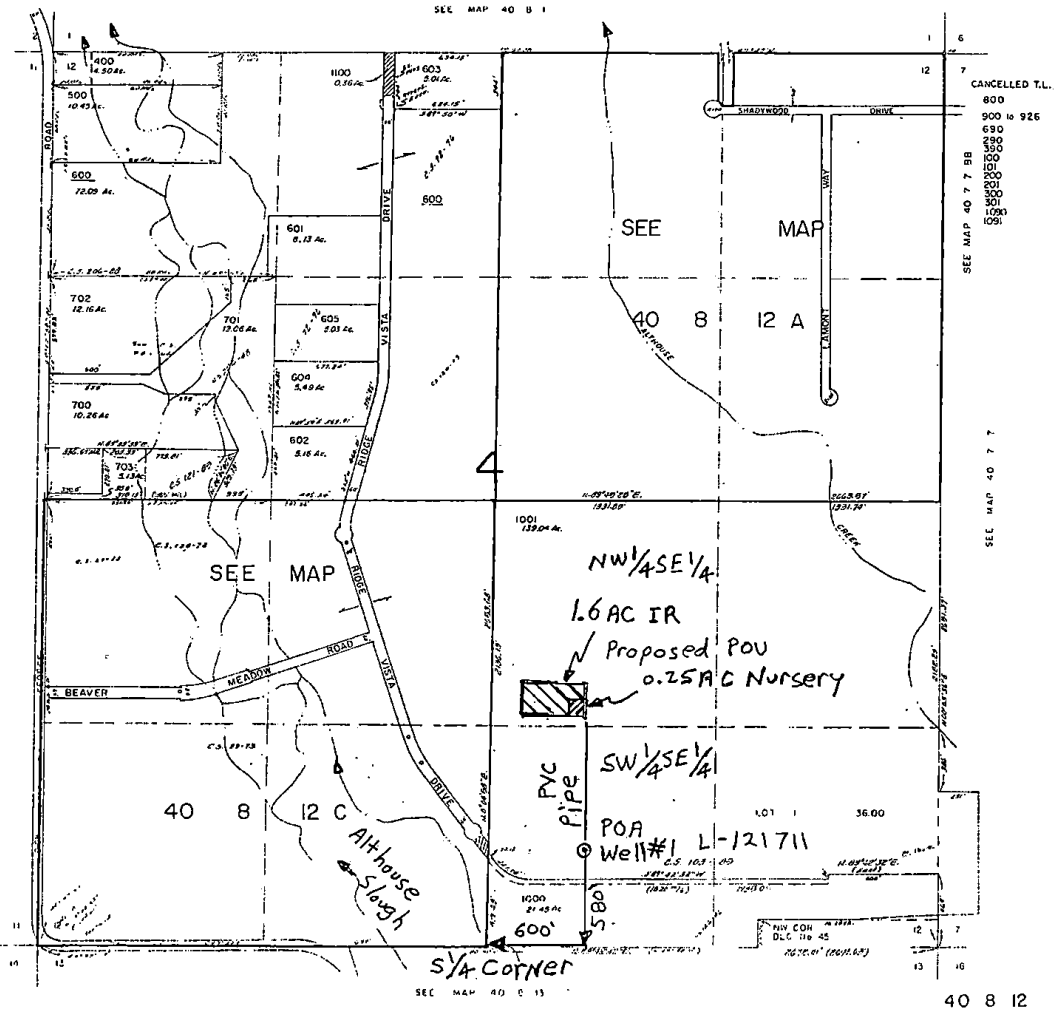

RECEIVED BY OWRD
APR 29 2016
SALEM, OR