


SW SW, Section 8,
T.19S. R.2W. W.M.
Lane County, Oregon
1" = 400'

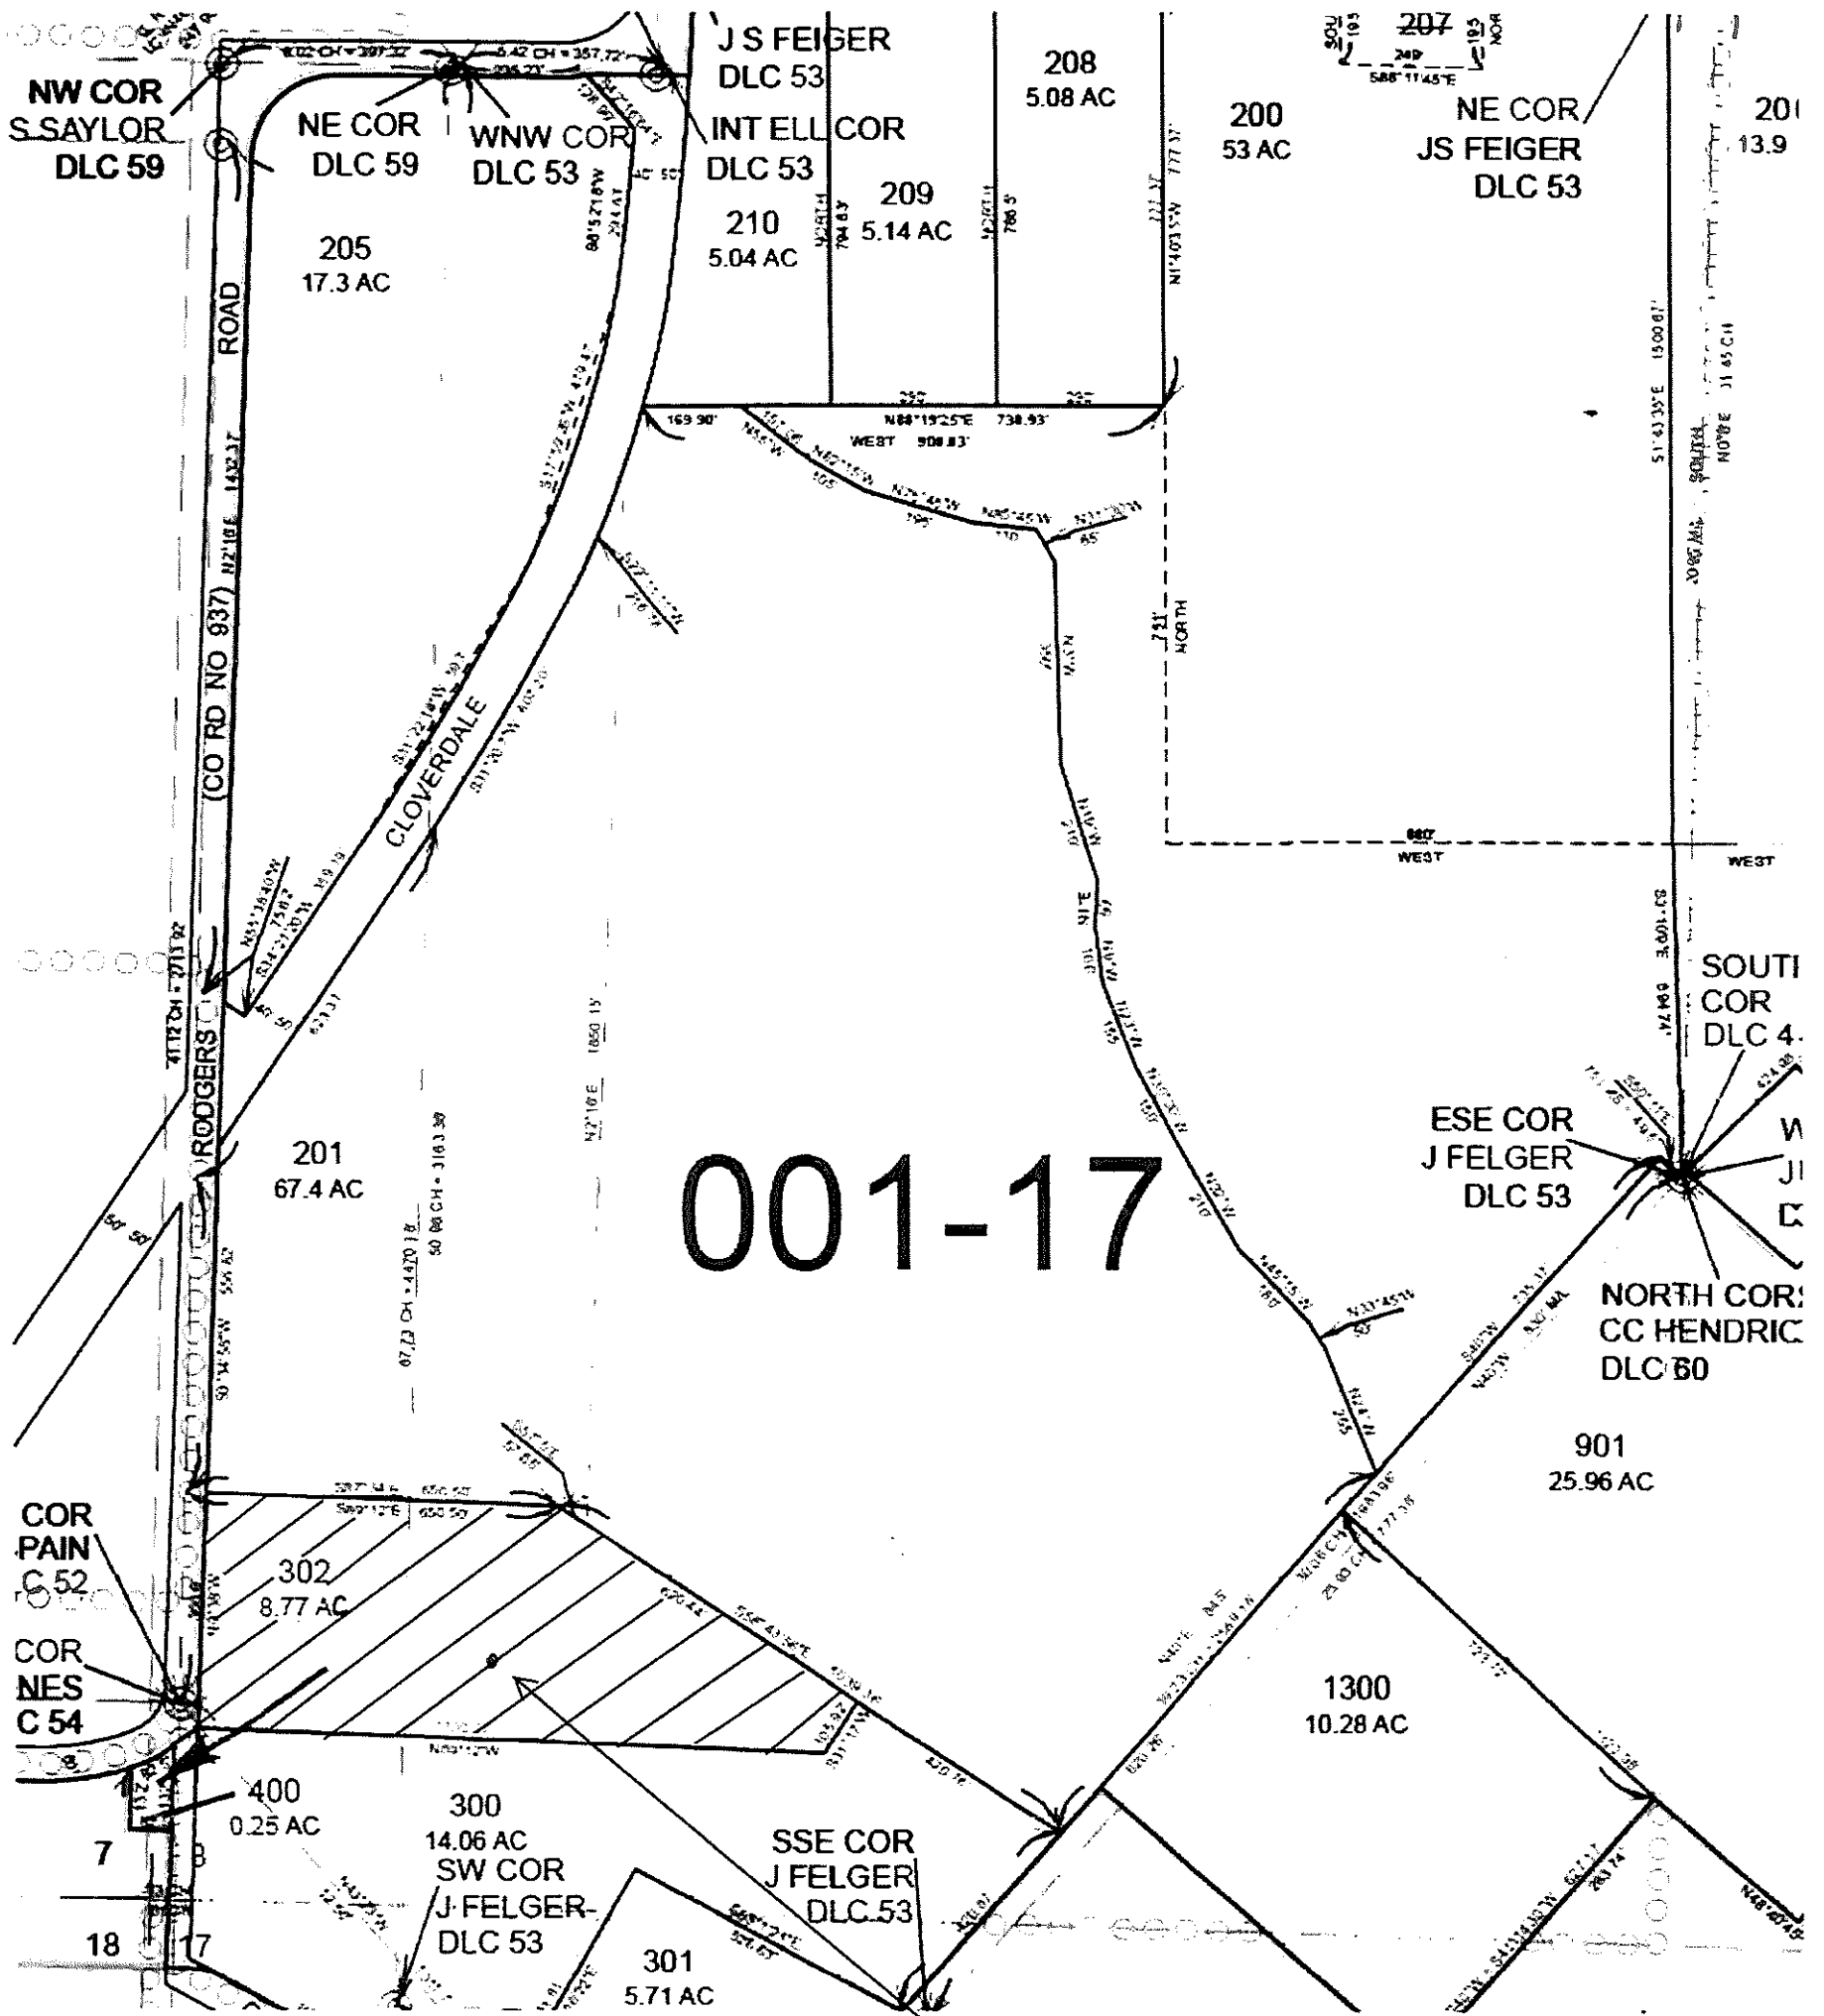

Well Location: 102.33 Feet North and 664.56 Feet East of NE Corner of DLC 54

648298

RECEIVED BY OWRD

OCT 11 2016

SALEM, OR