


# T.4S. R.4W. Section 11, W.M.

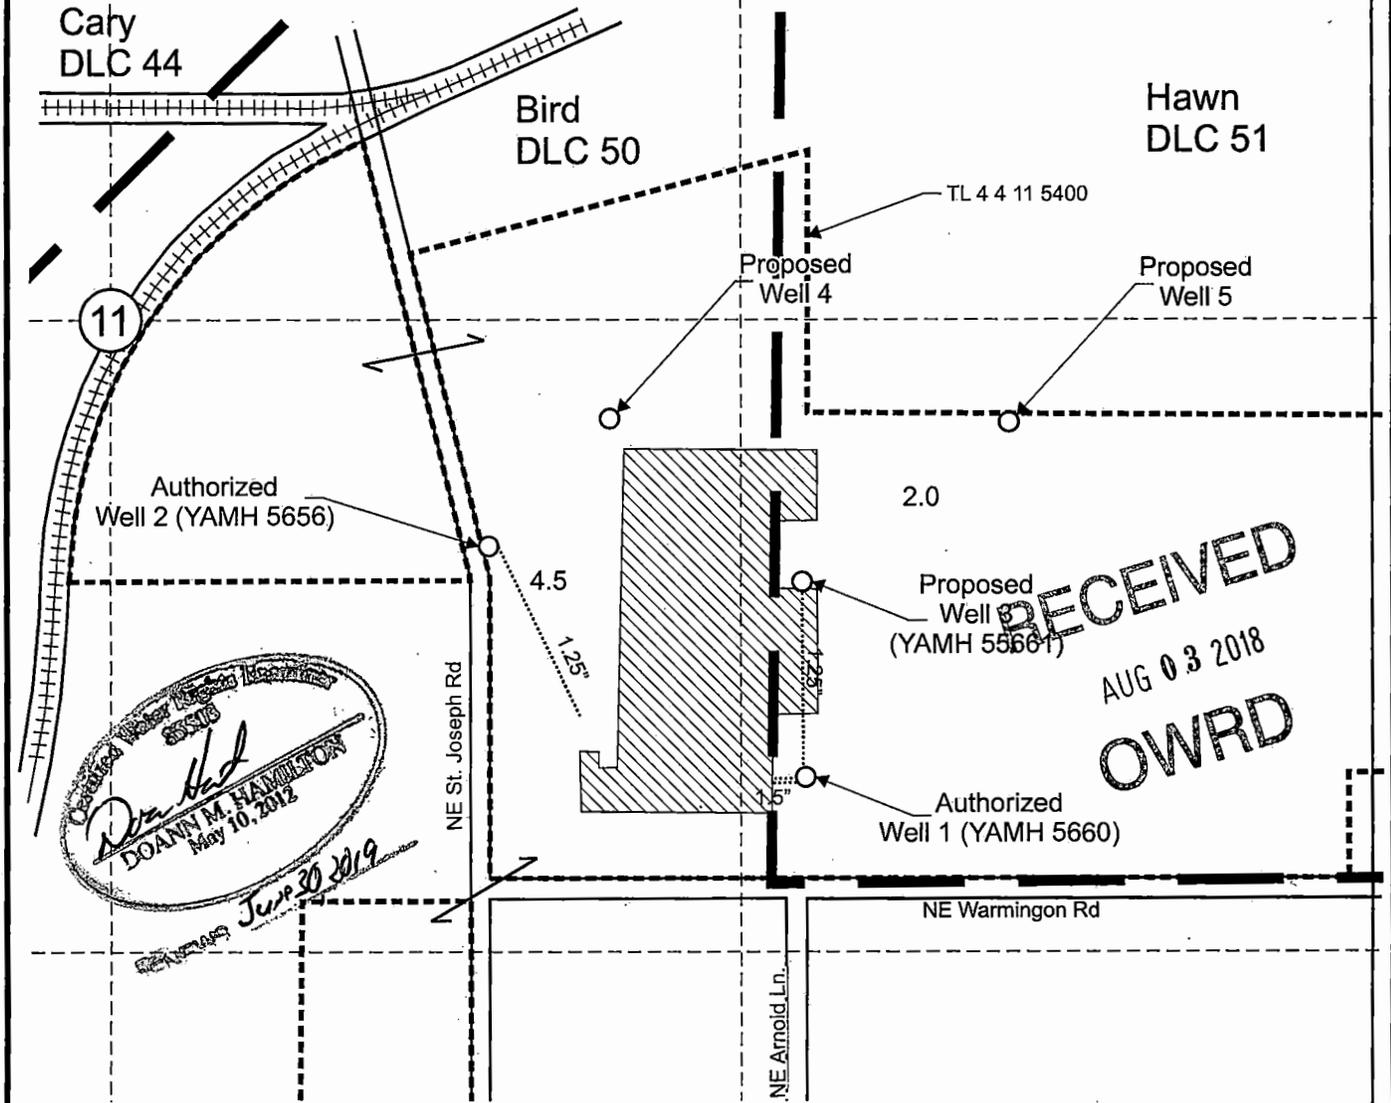

Authorized Well 1 (YAMH 5660) is located North 35° 30' west, 2,175 feet from the SE corner, Section 11.  
 Authorized Well 2 (YAMH 5656) is located North 41° 0' west, 2,860 feet from the SE corner, Section 11.  
 Proposed Well 3 (YAMH 55661) is located 550 feet south and 1,445 feet east from the Center corner, Section 11.  
 Proposed Well 4 is located 205 feet south and 1,045 feet east from the Center corner, Section 11.  
 Proposed Well 5 is located 215 feet south and 1,880 feet east from the Center corner, Section 11.


"To" Area (6.5 Acres) to be irrigated under Application G-15543, Permit G-15352.

Tax lot boundary

Donation Land Claim boundary

Mainlines

Scale: 1" = 400'

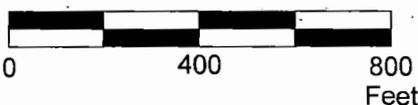

This map was prepared for the purpose of identifying the location of a water right only and is not intended to provide legal dimensions or location of property ownership lines.

Permit Amendment "To" Map  
 Application G-15543, Permit G-15352

North American Plants  
 T.4S. R.4W. Section 11, W.M.

07/2018

Pacific Hydro-Geology Inc.




11  
14

NAMPlantsPARevMap.cdr

*Do Ann M. Hamilton*  
 DOANN M. HAMILTON  
 May 10, 2012  

**RECEIVED**  
 AUG 03 2018  
**OWRD**


# T.4S. R.4W. Section 11, W.M.

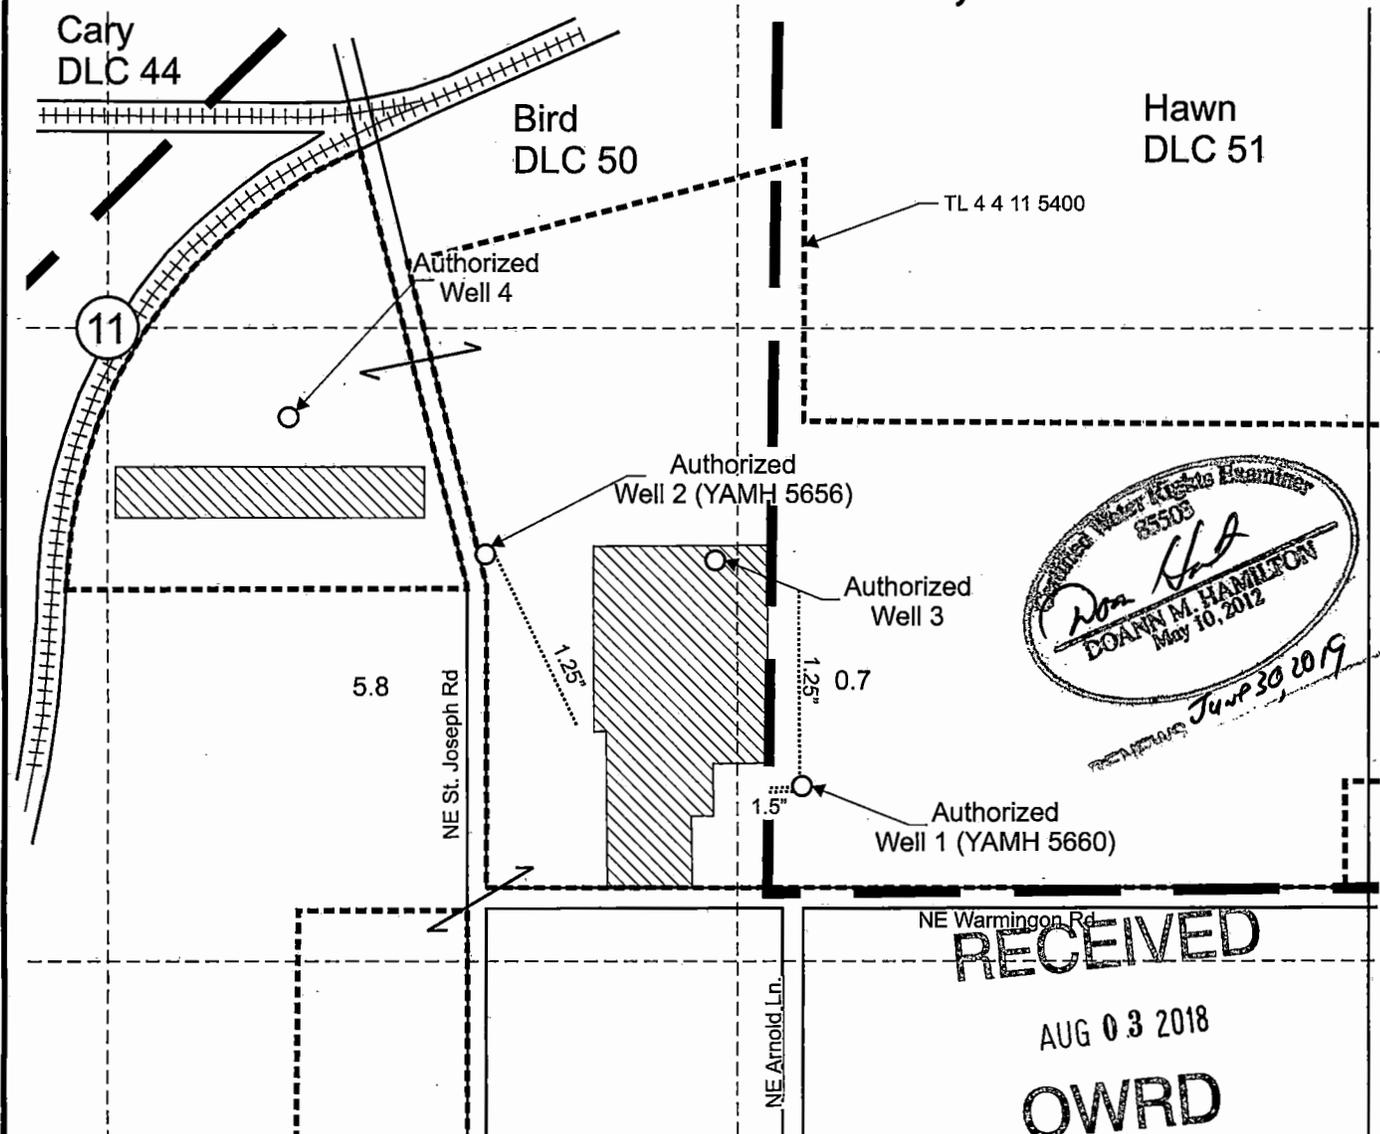

Doann M. Hamilton  
 May 10, 2012  
 JUN 30 2019


Authorized Well 1 (YAMH 5660) is located North 35° 30' west, 2,175 feet from the SE corner, Section 11.  
 Authorized Well 2 (YAMH 5656) is located North 41° 0' west, 2,860 feet from the SE corner, Section 11.  
 Authorized Well 3 is located North 32° 15' west, 2,550 feet from the SE corner, Section 11.  
 Authorized Well 4 is located North 42° 30' west, 3,350 feet from the SE corner, Section 11.

- "From" Area (6.5 Acres) to be irrigated under Application G-15543, Permit G-15352.
- Tax lot boundary
- Donation Land Claim boundary

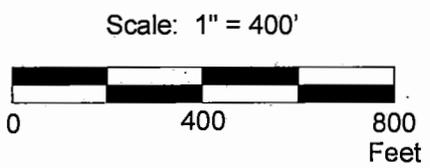

This map was prepared for the purpose of identifying the location of a water right only and is not intended to provide legal dimensions or location of property ownership lines.

**Permit Amendment "From" Map**  
**Application G-15543, Permit G-15352**  
 North American Plants  
 T.4S. R.4W. Section 11, W.M.

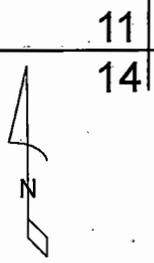

NAMPlantsPARRevMap.cdr

Pacific Hydro-Geology Inc.

07/2018



LEGEND

\* = D.L.C. MONUMENT

⊕ = EXISTING WELL

⊙ = PROPOSED WELL

● = WATER STORAGE


DASHED LINE = 1/4 1/4 SECTION-BOUNDARY

RECEIVED BY OWRD

FEB 21 2017

SALEM, OR

HAWN CREEK  
ELEV. 90'

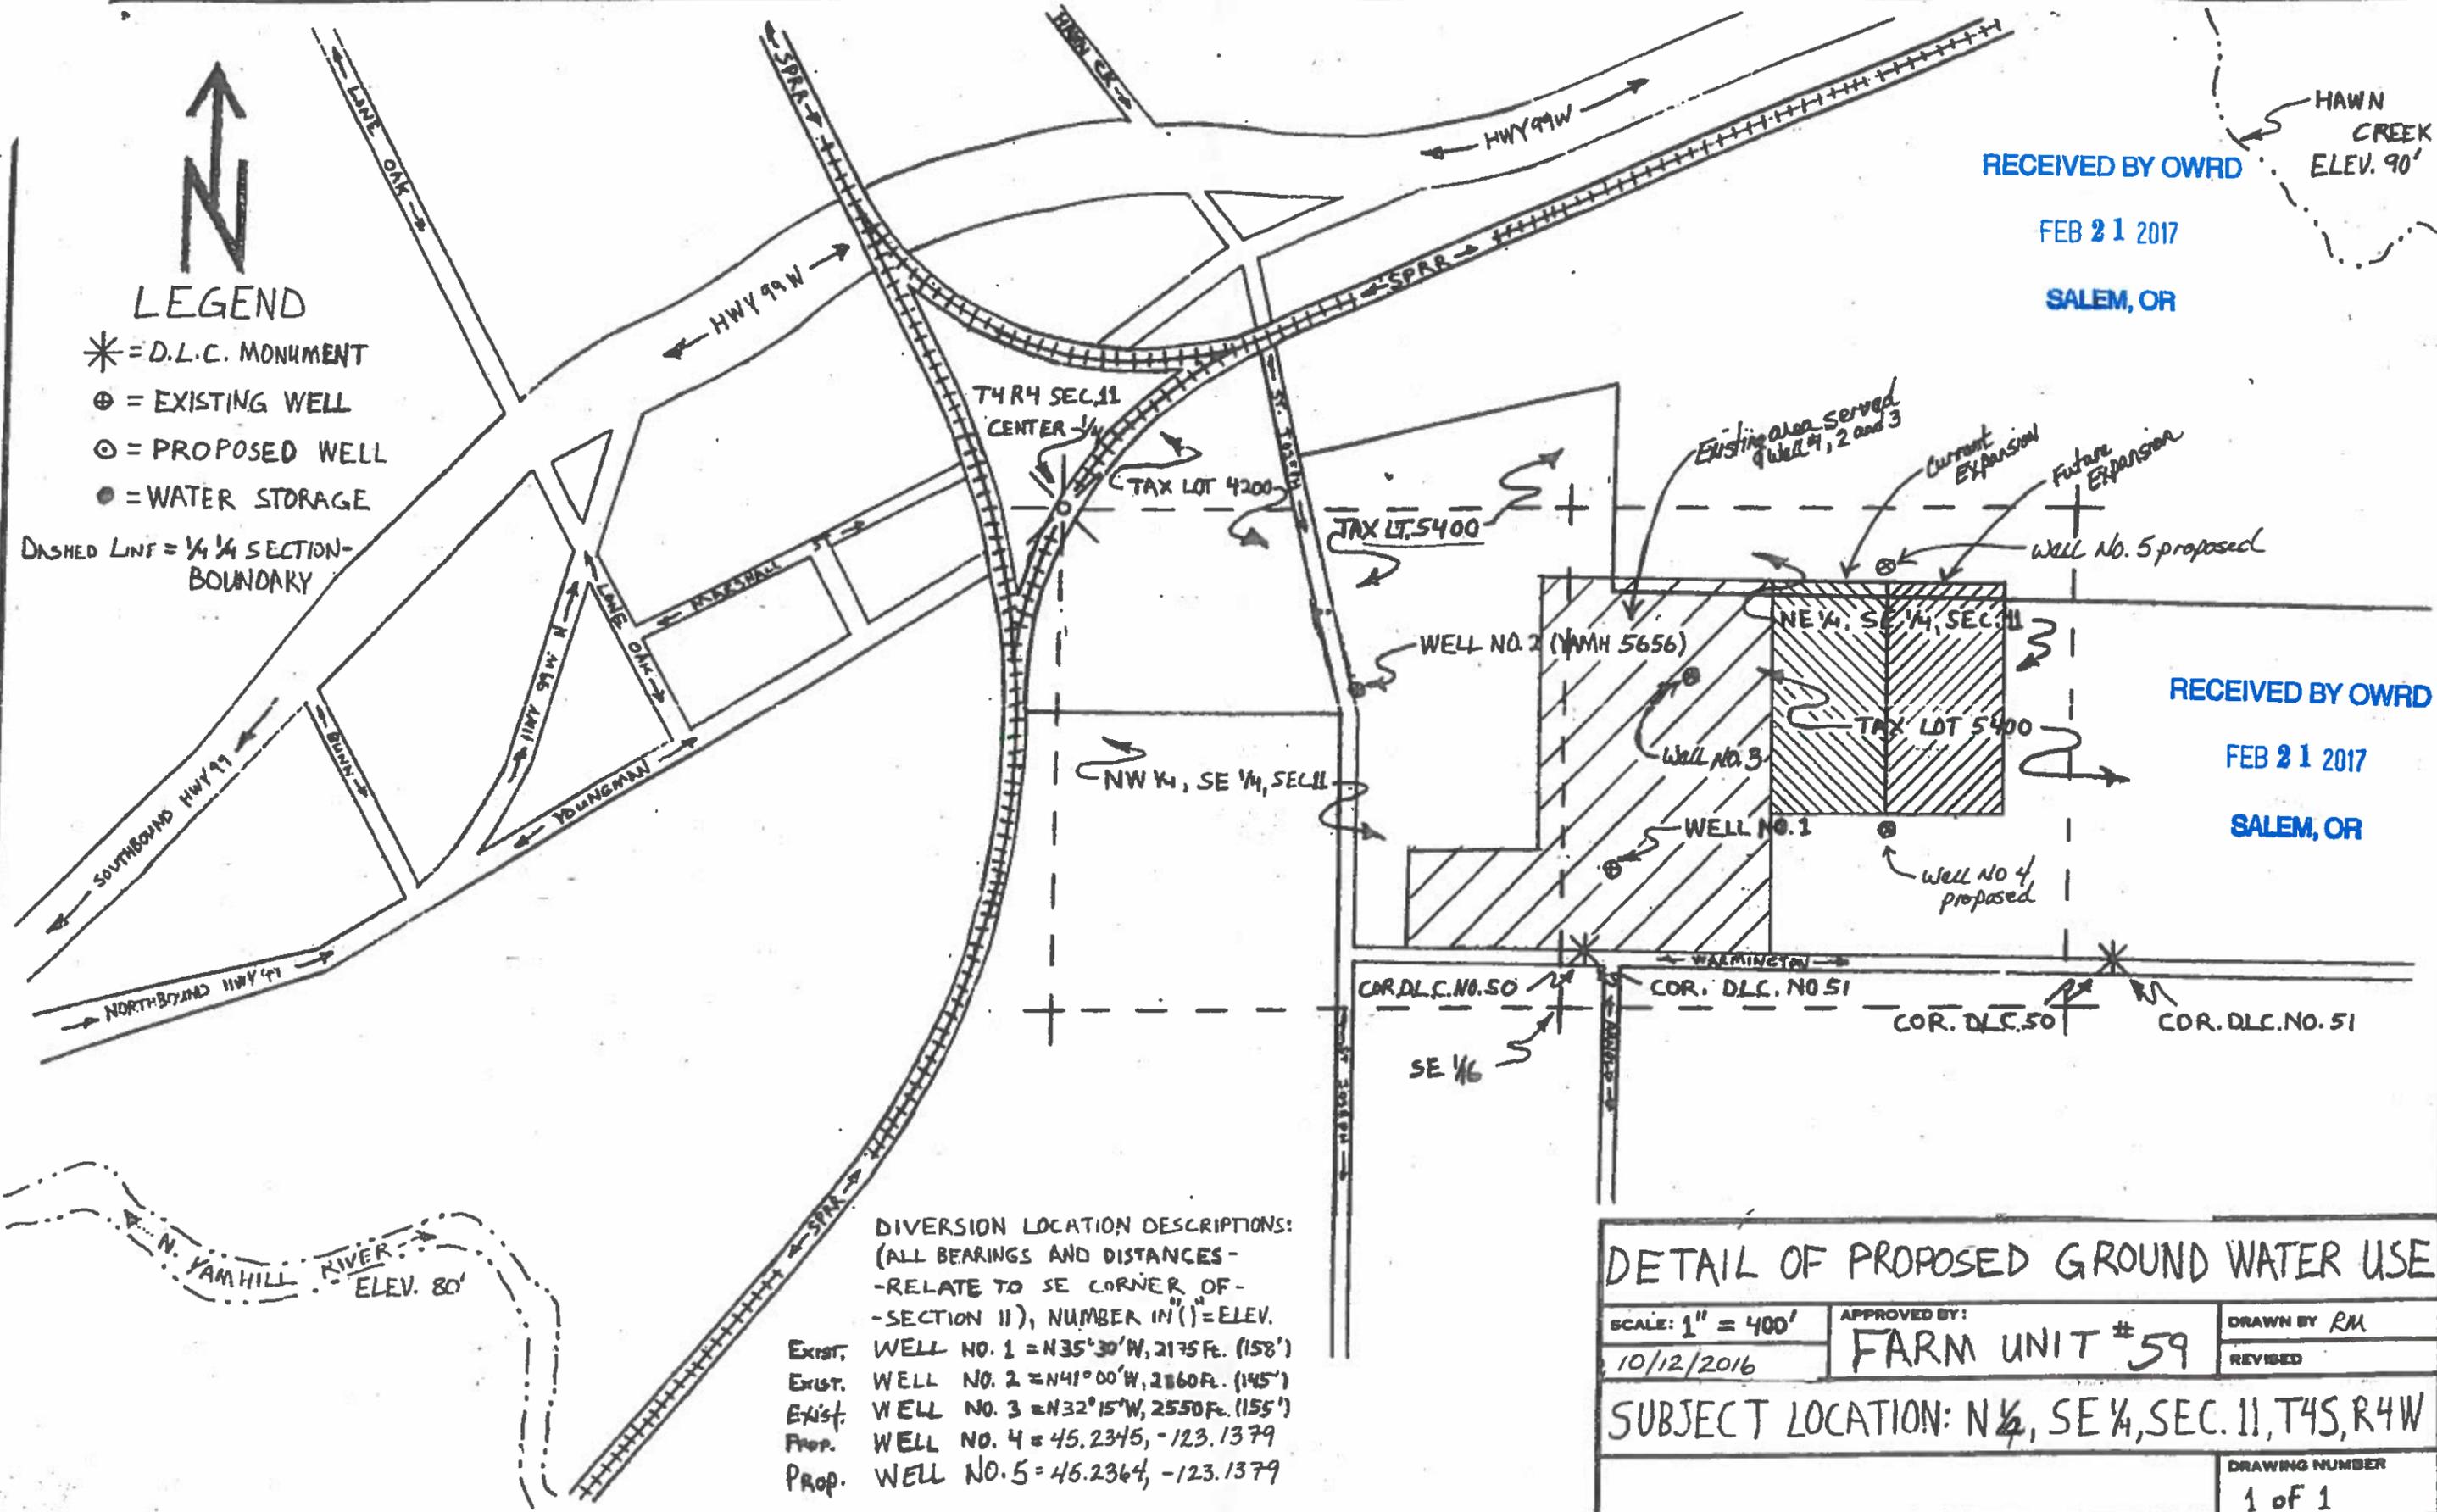

RECEIVED BY OWRD

FEB 21 2017

SALEM, OR

DIVERSION LOCATION DESCRIPTIONS:

(ALL BEARINGS AND DISTANCES -  
-RELATE TO SE CORNER OF -  
-SECTION 11), NUMBER IN ("') = ELEV.

- Exist. WELL NO. 1 = N35°30'W, 2175F. (158')
- Exist. WELL NO. 3 = N32°15'W, 2550F. (155')
- Prop. WELL NO. 4 = 45.2345, -123.1379
- Prop. WELL NO. 5 = 46.2364, -123.1379

DETAIL OF PROPOSED GROUND WATER USE

SCALE: 1" = 400'  
10/12/2016

APPROVED BY:  
FARM UNIT # 59

DRAWN BY RM  
REVISED

SUBJECT LOCATION: N 1/4, SE 1/4, SEC. 11, T4S, R4W

DRAWING NUMBER  
1 OF 1