

ROGER & SUSAN RUCKERT
 PERMIT G-14063
 APPLICATION G-15280


SEC 27
 T12S R3W

WELL LOCATION

- WELL #1 - 3100' W & 50' S
 - WELL #2 - 1960' W & 55' S
 - WELL #3 - 3365' W & 120' S
- FROM NE CORNER
 SEC 27

LEGEND

- MONUMENTED CORNER
- WELL

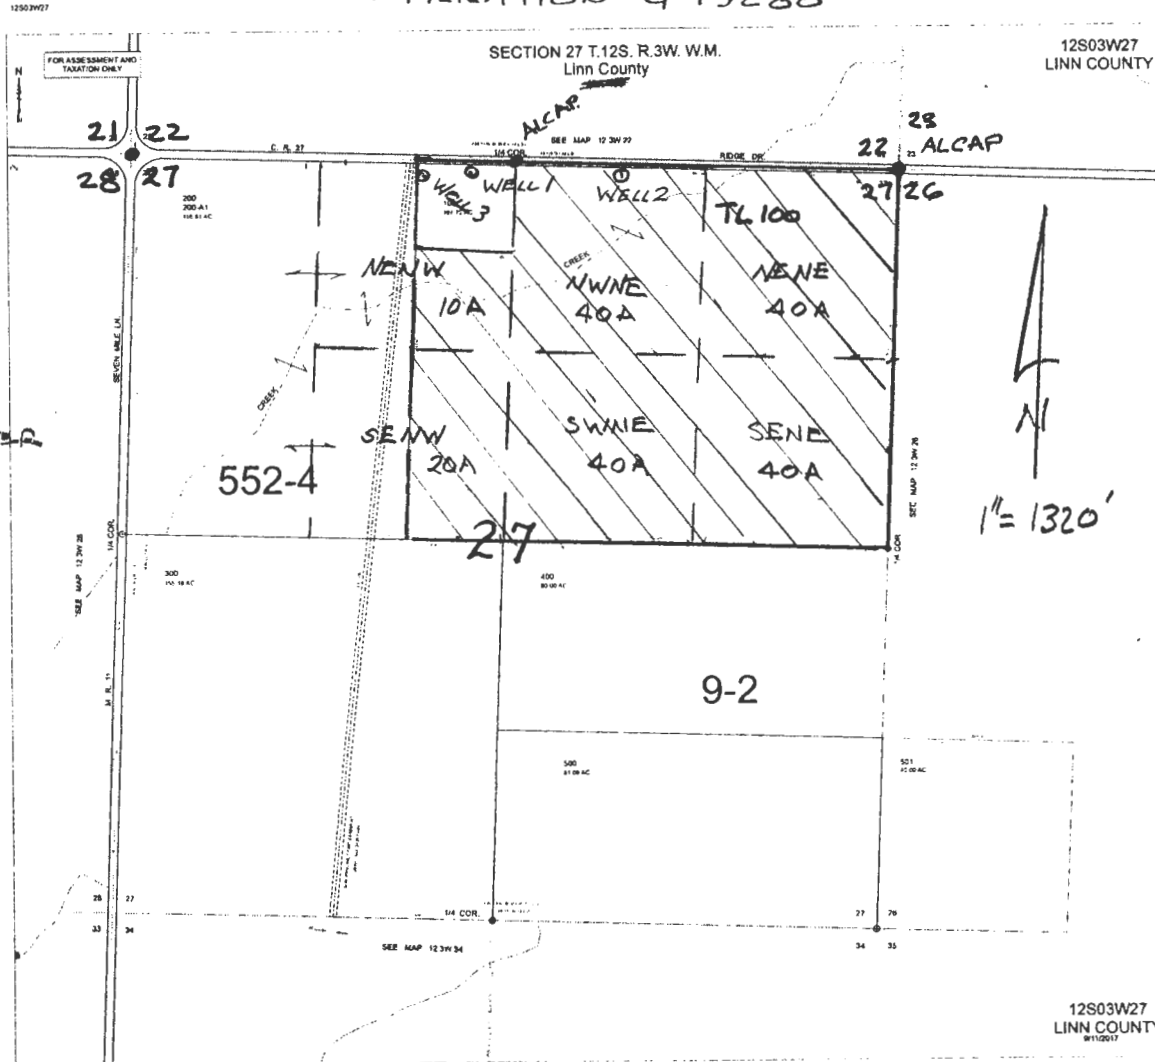

I 12778

RECEIVED BY OWRD

NOV 29 2017

SALEM, OR